

SURVEY & REMONUMENTATION

APR 28 1995

COMMISSION

LAND CORNER RECORDATION CERTIFICATE
 Filing Requirement of Act 74, Mich. P.A. 1970
 KENT COUNTY REMONUMENTATION

STATE OF MICHIGAN
 COUNTY OF KENT
 RECEIVED FOR RECORD

94 DEC -6 AM 8:59

W. J. Bond
 REG. OF DEEDS

For corners in

Kent (County)	Located in:	Corner Code #
1. Public Land Survey	T <u>6N</u> R <u>12W</u>	<u>L-6</u>
	T _____ R _____	_____
	T _____ R _____	_____
	T _____ R _____	_____
2. Property Controlling in Section	S _____ T _____ R _____	_____
	S _____ T _____ R _____	_____
3. Miscellaneous Property in Sec.	S _____ T _____ R _____	_____
	S _____ T _____ R _____	_____

7758

Register of Deeds Stamp & File Number

4. Lot No. _____, Recorded Plat _____
 5. Private Claims _____

I, Randy Kolehouse, in a field survey on June 14 19 94, do hereby certify that under requirements of P.A. 74 Michigan P.A. of 1970, the corner points mentioned in lines 1 and 2 above were in conformance with regulations and rules therefore as required in the current manual of survey instructions of the United States Department of the Interior, Bureau of Land Management or by a decree of a Court of Law and/or that the corner points mentioned in lines 3, 4 and 5 above were in conformance with the rules of the Michigan Board of Land Surveyors or by a Decree of a Court of Law; established, re-established, monumented, re-monumented, recovered, found as expressed below:

NOTE: Not more than 4 corners, all in the same town and range, may be recorded on this certificate.

A. Description of original monument and accessories and/or subsequent restoration:

L-6 This corner was not originally set by the G.L.O.

Year	Survey Notes	Surveyor	Monument
1928	Survey Notes	Williams & Works	N/A
1941	Survey Notes	Williams & Works	Set R.R. Spike per 1928 Survey
1976	L.C.R.C. #907	Exxel Engineering	1/2" Iron
1976	L.C.R.C. #930	Moore & Bruggink	1/2" Iron
1984	L.C.R.C. #3825	Exxel Engineering	1/2" Iron
1993	L.C.R.C. #6880	Bueche	Set K.C. Mon.

B. Description of corner evidence found and/or method applied in restoring or reestablishing corner:

L-6 Found K.C. Monument in C/L 32nd Street E-W 9.57' East of C/L R.R. track N-S per L.C.R.C. #6880. This point checks Williams & Works survey records and L.C.R.C.'s #907, #930 and #3825. K.C. Monument is 0.8' West of intersection of 1/4 lines. Accepted as Center Section.

P.A. 345 1990 KENT COUNTY


PEER APPROVED B/29/94

CHAIRMAN *Harry Hubert*

C. Description of monument for corner and accessories established to perpetuate locating the position of the corner:

L-6 Standard K.C. Monument

- SW corner building N 60° E 143.36'
- SW corner signal box N 30° W 48.53'
- P.K. in R.R. Tie C/L R.R. N 15° W 88.53'
- C/L R.R. Wet 9.57'
- Nail & K.C. remon. tag in S side g. pole N 65° W 101.98'
- NE corner conc. walk W of R.R. tracks N 20° W 35.54'

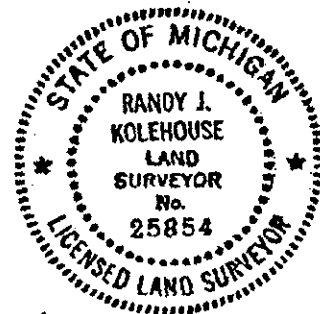

Signed by Randy J. Kolehouse

Date 12/1/94

Surveyor's Michigan License No. _____

25854