

SURVEY & REMONUMENTATION

APR 28 1995

Kent County Remonumentation

STATE OF MICHIGAN
COUNTY OF KENT
RECEIVED FOR RECORD

COMMISSION

LAND CORNER RECORDATION CERTIFICATE 94 NOV 29 AM 9:25
Filing Requirement of Act 74, Mich. P.A. 1970

For corners in
Kent

(County)	Located In:	Corner Code #
1. Public Land Survey	T <u>6N</u> R <u>12W</u>	<u>L-7</u>
	T _____ R _____	_____
	T _____ R _____	_____
	T _____ R _____	_____
2. Property Controlling in Section	S _____ T _____ R _____	_____
	S _____ T _____ R _____	_____
3. Miscellaneous Property in Sec.	S _____ T _____ R _____	_____
	S _____ T _____ R _____	_____

W. J. Bond
REG. OF DEEDS

7497

Register of Deeds Stamp & File Number

4. Lot No. _____, Recorded Plat _____
5. Private Claims _____

	A	B	C	D	E	F	G	H	I	J	K	L	M
2	6		5		4		3		2		1		
3													
4	7		8		9		10		11		12		
5													
6	13		17		16		15		14		13		
7													
8	19		20		21		22		23		24		
9													
10	30		29		28		27		26		25		
11													
12	31		32		33		34		35		36		
13													

I, Randy Kolehouse, in a field survey on April 7, 19 94, do hereby certify that under requirements of P.A. 74, Michigan P.A. of 1970, the corner points mentioned in lines 1 and 2 above were in conformance with regulations and rules therefore as required in the current manual of survey instructions of the United States Department of the Interior, Bureau of Land Management or by a decree of a Court of Law and/or that the corner points mentioned in lines 3, 4 and 5 above were in conformance with the rules of the Michigan Board of Land Surveyors or by a Decree of a Court of Law; established, re-established, monumented, re-monumented, recovered, found as expressed below:

NOTE: Not more than 4 corners, all in the same town and range, may be recorded on this certificate.

A. Description of original monument and accessories and/or subsequent restoration:

L-7	1831	G.L.O. Notes	L. Lyon	Set Post
	N/A	Wit. Map	K.C. Surveyor	N/A
	1983	L.C.R.C. #3464	Exxel Engineering	Rerod
	1987	L.C.R.C. #4515	Exxel Engineering	Set K.C. Mon.

The position of this corner was previously approved by the Kent County Remonumentation Peer Group monumented by Exxel Engineering on 6/27/87 and was recorded per L.C.R.C. #4515.

B. Description of corner evidence found and/or method applied in restoring or reestablishing corner:

L-7 Found K.C. Monument in C/L of 36th Street per L.C.R.C. #4515 as set by Exxel Engineering after road construction in place of a rerod they found which checked K.C. Wit. Map.

L.C.R.C. #4515


- SW cor. 2' x 2' base plate of RR signal N 31° E 31.20'
- NE cor. 2' x 2' base plate of RR signal S 61° W 53.33'
- PK in remon tag. in top wooden guard post N 69° E 92.14'
- PK in remon tag. at SW cor. of CB in curb S 66° E 86.00'
- East edge of E'y rail of RR track W 10.28'

P.A. 345 1990 KENT COUNTY
PEER APPROVED 9/22/94
CHAIRMAN Stacy Huber

The selected location is accepted by me and is generally accepted by professional surveyors as the best available evidence of the position of the original corner.

C. Description of monument for corner and accessories established to perpetuate locating the position of the corner:

- L-7 Standard Kent County Monument
- SW cor. 2' x 2' base plate of RR signal N 31° E 31.20'
 - NE cor. 2' x 2' base plate of RR signal S 61° W 53.33'
 - PK & remon. tag in top wooden guard post N 69° E 92.14'
 - PK & remon. tag at SW cor. of CB in curb S 66° E 86.00'
 - East edge of E'y rail of RR track W 10.28'

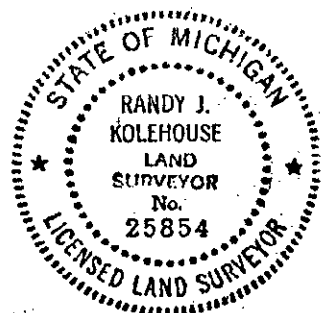

Signed by Randy J. Kolehouse
Surveyor's Michigan License No. 25854

Date 11/21/94