

SURVEY & REMONUMENTATION

APR 28 1995

COMMISSION

For corners in

Kent
(County)

Located in:

Corner Code #

1. Public Land Survey	T <u>6N</u>	R <u>12W</u>	<u>L-8</u>
	T _____	R _____	_____
	T _____	R _____	_____
	T _____	R _____	_____
2. Property Controlling in Section	S _____	T _____	R _____
	S _____	T _____	R _____
3. Miscellaneous Property in Sec.	S _____	T _____	R _____
	S _____	T _____	R _____

STATE OF MICHIGAN
COUNTY OF KENT
RECEIVED FOR RECORD

DEC -6 AM 8:59

W. J. Bond

REG. OF DEEDS

7757

Register of Deeds Stamp & File Number

4. Lot No. _____, Recorded Plat _____
5. Private Claims _____

	A	B	C	D	E	F	G	H	I	J	K	L	V
2	6	5	4	3	2	1							
3													
4	7	8	9	10	11	12							
5													
6	18	17	16	15	14	13							
7													
8	19	20	21	22	23	24							
9													
10	30	29	28	27	26	25							
11													
12	31	32	33	34	35	36							
13													

I, Randy Kolehouse, in a field survey on November 4 19 94, do hereby certify that under requirements of P.A. 74 Michigan P.A. of 1970, the corner points mentioned in lines 1 and 2 above were in conformance with regulations and rules therefore as required in the current manual of survey instructions of the United States Department of the Interior, Bureau of Land Management or by a decree of a Court of Law and/or that the corner points mentioned in lines 3, 4 and 5 above were in conformance with the rules of the Michigan Board of Land Surveyors or by a Decree of a Court of Law; established, re-established, monumented, re-monumented, recovered, found as expressed below:

NOTE: Not more than 4 corners, all in the same town and range, may be recorded on this certificate.

A. Description of original monument and accessories and/or subsequent restoration:

L-8 This corner was not originally set by the G.L.O.

1939	Survey Records	Williams & Works	Set Iron
1939-1986	Survey Records	Williams & Works	Iron
1976	Survey Records	Exxel Engineering	Set Iron
1986	Survey Records	Williams & Works	Reset "T" Iron

B. Description of corner evidence found and/or method applied in restoring or reestablishing corner:


L-8 Found "T" iron as reset by Williams & Works on the line of plats East (McQueen and Doyle Park Subs.) and using tie to C/L of railroad running N-S per railroad right-of-way maps. This iron is 1.9' South and 0.3' West of the intersection of 1/4 lines. Accepted Iron as Center Section. Note: Exxel Engineering iron has been removed due to railroad construction.

P.A. 345 1990 KENT COUNTY
PEER APPROVED 11/17/94
CHAIRMAN Harry Huber

C. Description of monument for corner and accessories established to perpetuate locating the position of the corner:

L-8 Replaced "T" iron with a Standard 4" x 30" Kent County Monument.

- Nail & K.C. remon. tag in SW side p. pole N 38° W 81.63'
- Center of top bolt on N side NE'ly power tower S 85° W 70.19'
- Nail in railroad tie West 7.12'
- P.K. Nail & K.C. remon. tag in railroad tie S 10° W 66.87'
- P.K. Nail & K.C. remon. tag in railroad tie S 25° E 49.47'

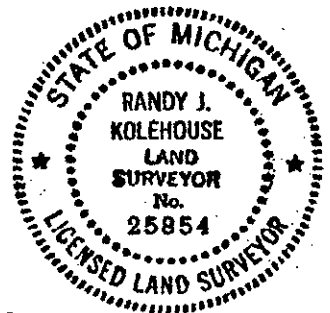

Signed by Randy J. Kolehouse Date 12/1/94
Surveyor's Michigan License No. 25854