

SURVEY & REMONUMENTATION

APR 28 1995

LAND CORNER RECORDATION CERTIFICATE

Filing Requirement of Act 74, Mich. P.A. 1970
KENT COUNTY REMONUMENTATION

STATE OF MICHIGAN
COUNTY OF KENT
RECEIVED FOR RECORD

94 DEC -6 AM 8:59

COMMISSION

For corners in

Kent (County)	Located in:	Corner Code #
1. Public Land Survey	T <u>6N</u> R <u>12W</u>	<u>L-10</u>
	T _____ R _____	_____
	T _____ R _____	_____
	T _____ R _____	_____
2. Property Controlling in Section	S _____ T _____ R _____	_____
	S _____ T _____ R _____	_____
3. Miscellaneous Property in Sec.	S _____ T _____ R _____	_____
	S _____ T _____ R _____	_____

W. J. Bond
REG. OF DEEDS

7753

Register of Deeds Stamp & File Number

4. Lot No. _____, Recorded Plat _____
5. Private Claims _____

	A	B	C	D	E	F	G	H	I	J	K	L	N
2	6	5	4	3	2	1							
3													
4	7	8	9	10	11	12							
5													
6	18	17	16	15	14	13							
7													
8	19	20	21	22	23	24							
9													
10	30	29	28	27	26	25							
11													
12	31	32	33	34	35	36							
13													

I, Randy Kolehouse, in a field survey on November 4 19 94, do hereby certify that under requirements of P.A. 74 Michigan P.A. of 1970, the corner points mentioned in lines 1 and 2 above were in conformance with regulations and rules therefore as required in the current manual of survey instructions of the United States Department of the Interior, Bureau of Land Management or by a decree of a Court of Law and/or that the corner points mentioned in lines 3, 4 and 5 above were in conformance with the rules of the Michigan Board of Land Surveyors or by a Decree of a Court of Law; established, re-established, monumented, re-monumented, recovered, found as expressed below:

NOTE: Not more than 4 corners, all in the same town and range, may be recorded on this certificate.

A. Description of original monument and accessories and/or subsequent restoration:

L-10 This corner was not originally set by the G.L.O.
1957 Survey Records Williams & Works Set Iron


B. Description of corner evidence found and/or method applied in restoring or reestablishing corner:

L-10 Iron set in 1957 by Williams & Works has been destroyed due to railroad construction. Per notes, iron was set on the N-S 1/4 line and on line of Phernamberg and Darby Sharpteens Plat to the East to honor these plats. Per notes, this point is 7.5 ± South of the E-W 1/4 line. Per Exxel Engineering, they have been holding the same location and show point to be 7.7' South of E-W 1/4 line. Reset Center Section on N-S 1/4 line 7.7' South of the E-W 1/4 line.

P.A. 345 1990 KENT COUNTY
PEER APPROVED 11/12/94
CHAIRMAN *Harry Kukulur*

C. Description of monument for corner and accessories established to perpetuate locating the position of the corner:

L-10 Set Standard 4" x 30" Kent County Monument.
Nail & K.C. remon. tag in S side 26" Ash East 90.00'
SW corner conc. block bldg. N 78° E 68.79'
NW corner conc. block bldg. N 37° E 116.21'
*+ in North bolt of wall beam

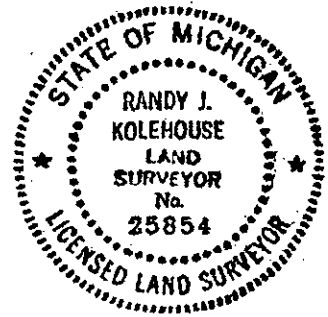

Signed by *Randy J. Kolehouse* Date 12/1/94
Surveyor's Michigan License No. 25854