

SURVEY & REMONUMENTATION

Kent County Remonumentation

APR 28 1995

LAND CORNER RECORDATION CERTIFICATE
COMMISSION Filing Requirement of Act 74, Mich. P.A. 1970

STATE OF MICHIGAN
 COUNTY OF KENT
 RECEIVED FOR RECORD

94 NOV 29 AM 9:25

W. J. Bond
 REG. OF DEEDS

For corners in
Kent
 (County)

	Located In:	Corner Code #/
1. Public Land Survey	T <u>6N</u> R <u>12W</u>	<u>M-2</u>
	T _____ R _____	_____
	T _____ R _____	_____
	T _____ R _____	_____
2. Property Controlling in Section	S _____ T _____ R _____	_____
	S _____ T _____ R _____	_____
3. Miscellaneous Property in Sec.	S _____ T _____ R _____	_____
	S _____ T _____ R _____	_____

7502
 Register of Deeds Stamp & File Number

4. Lot No. _____, Recorded Plat _____
 5. Private Claims _____

I, Randy Kolehouse, in a field survey on July 19, 19 94, do hereby certify that under requirements of P.A. 74, Michigan P.A. of 1970, the corner points mentioned in lines 1 and 2 above were in conformance with regulations and rules therefore as required in the current manual of survey instructions of the United States Department of the Interior, Bureau of Land Management or by a decree of a Court of Law and/or that the corner points mentioned in lines 3, 4 and 5 above were in conformance with the rules of the Michigan Board of Land Surveyors or by a Decree of a Court of Law; established, re-established, monumented, re-monumented, recovered, found as expressed below:

NOTE: Not more than 4 corners, all in the same town and range, may be recorded on this certificate.

	A	B	C	D	E	F	G	H	I	J	K	L	M
2	6	5	4	3	2	1							
3													
4	7	8	9	10	11	12							
5													
6	16	17	16	15	14	13							
7													
8	19	20	21	22	23	24							
9													
10	30	29	28	27	26	25							
11													
12	31	32	33	34	35	36							
13													

A. Description of original monument and accessories and/or subsequent restoration:

M-2	1831	G.L.O. Notes	L. Lyon	Set Post	P.A. 345 1990 KENT COUNTY
	1912-1927	Survey Notes	Williams & Works	City Iron	PEER APPROVED <u>8/11/99</u>
	1931-1956	Survey Notes	City of Grand Rapids	City Iron	CHAIRMAN <u>[Signature]</u>
	1984	L.C.R.C. #3900	William Byl	Set K.C. Mon.	
	1988	L.C.R.C. #4716	Bueche	K.C. Mon.	

The position of this corner was previously approved by the Kent County Remonumentation Peer Group monumented by William R. Byl on 4/9/84 and was recorded per L.C.R.C. #3900.

B. Description of corner evidence found and/or method applied in restoring or reestablishing corner:

M-2 Found K.C. Monument in C/L of Division Avenue N-S 19.8' N of C/L of Crofton running East per L.C.R.C.'s #3900 & #4716 as set by William Byl using survey information from Williams & Works (1912-27) and the City of Grand Rapids (1931-56).

L.C.R.C. #4716

L.C.R.C. #3900


SW corner brick bldg. N 75° E 45.55'
 NW corner brick bldg. S 30° E 76.07'
 "V"-in face of light pole S 45° W 36.93'
 K.C. mon. (W 1/4 cor. Sec. 6, 6-11) S 00° W 19.80'
 On C/L bit N-S, C/L bit E is S 19.80'

SW corner brick bldg. N 75° E 45.55'
 NW corner brick bldg. S 30° E 76.07'
 "V"-face of light pole S 45° W 36.93'
 K.C. mon. (W 1/4 cor. Sec. 6, 6-11) S 00° W 19.80'

The selected location is accepted by me and is generally accepted by professional surveyors as the best available evidence of the position of the original corner.

C. Description of monument for corner and accessories established to perpetuate locating the position of the corner:

M-2 Standard Kent County Monument
 SW cor. brick bldg. N 75° E 45.55'
 NW cor. brick bldg. S 30° E 76.07'
 "V"-face of light pole S 45° W 36.93'
 Kent County Monument (W 1/4 cor. Sec. 6, 6-11) S 00° W 19.80'

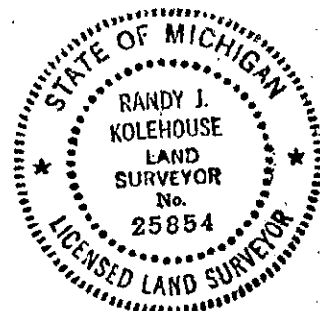

Signed by *Randy J. Kolehouse* Date 11/21/99
 Surveyor's Michigan License No. 25854