

SURVEY & REMONUMENTATION

Kent County Remonumentation

APR 28 1995

STATE OF MICHIGAN
COUNTY OF KENT
RECEIVED FOR RECORD

COMMISSION LAND CORNER RECORDATION CERTIFICATE

NOV 29 AM 9:25

Filing Requirement of Act 74, Mich. P.A. 1970

For corners in
Kent

(County)

Located In:

Corner Code #

- | | | |
|------------------------------------|-------------------------|-------|
| 1. Public Land Survey | T 6N R 12W | M-4 |
| | T _____ R _____ | _____ |
| | T _____ R _____ | _____ |
| | T _____ R _____ | _____ |
| 2. Property Controlling in Section | S _____ T _____ R _____ | _____ |
| | S _____ T _____ R _____ | _____ |
| 3. Miscellaneous Property in Sec. | S _____ T _____ R _____ | _____ |
| | S _____ T _____ R _____ | _____ |

Tracy Bond
REG. OF DEEDS

7504

Register of Deeds Stamp & File Number

4. Lot No. _____, Recorded Plat _____
5. Private Claims _____

| | A | B | C | D | E | F | G | H | I | J | K | L | M |
|----|----|----|----|----|----|----|---|---|---|---|---|---|---|
| 2 | 6 | 5 | 4 | 3 | 2 | 1 | | | | | | | |
| 3 | | | | | | | | | | | | | |
| 4 | 7 | 8 | 9 | 10 | 11 | 12 | | | | | | | |
| 5 | | | | | | | | | | | | | |
| 6 | 18 | 17 | 16 | 15 | 14 | 13 | | | | | | | |
| 7 | | | | | | | | | | | | | |
| 8 | 19 | 20 | 21 | 22 | 23 | 24 | | | | | | | |
| 9 | | | | | | | | | | | | | |
| 10 | 30 | 29 | 28 | 27 | 26 | 25 | | | | | | | |
| 11 | | | | | | | | | | | | | |
| 12 | 31 | 32 | 33 | 34 | 35 | 36 | | | | | | | |
| 13 | | | | | | | | | | | | | |

I, Randy Kolehouse, in a field survey on July 19, 19 94, do hereby certify that under requirements of P.A. 74, Michigan P.A. of 1970, the corner points mentioned in lines 1 and 2 above were in conformance with regulations and rules therefore as required in the current manual of survey instructions of the United States Department of the Interior, Bureau of Land Management or by a decree of a Court of Law and/or that the corner points mentioned in lines 3, 4 and 5 above were in conformance with the rules of the Michigan Board of Land Surveyors or by a Decree of a Court of Law; established, re-established, monumented, re-monumented, recovered, found as expressed below:

NOTE: Not more than 4 corners, all in the same town and range, may be recorded on this certificate.

A. Description of original monument and accessories and/or subsequent restoration:

| | | | | |
|-----|------|----------------|----------------------|---------------|
| M-4 | 1831 | G.L.O. Notes | L. Lyon | Set Post |
| | 1931 | Survey Records | City of Grand Rapids | City Iron |
| | 1984 | L.C.R.C. #3902 | William Byl | Set K.C. Mon. |
| | 1988 | L.C.R.C. #4718 | Bueche | K.C. Mon |

P.A. 345 1990 KENT COUNTY

PEER APPROVED 11/11/94
CHAIRMAN *[Signature]*

The position of this corner was previously approved by the Kent County Remonumentation Peer Group monumented by William R. Byl on 4/9/84 and was recorded per L.C.R.C. #3902.

B. Description of corner evidence found and/or method applied in restoring or reestablishing corner:

M-4 Found K.C. Monument in C/L of Division Avenue N-S per L.C.R.C.'s #3902 and #4718 as set by William Byl using survey records from the City of Grand Rapids. This point checks to W 1/4 of Section 7, T6N, R11W, per survey records of Williams & Works.

L.C.R.C. #4718

L.C.R.C. #3902


"V"-face of light pole N 40° W 50.60'
SE cor. brick bldg. @ back of walk N 90° W 44.22'
NE cor. brick bldg. S 60° W 61.11'
SE cor. brick bldg. S 40° W 85.62'
Kent County Monument (W 1/4 cor. Sec. 7, 6-11) S 00° E 32.30'
On C/L bit N & S PK N 1.0' and W 1.02'

"V"-face of light pole N 40° W 50.60'
SE cor. brick bldg. @ back of walk N 90° W 44.22'
NE cor. brick bldg. S 60° W 61.11'
SE cor. brick bldg. S 40° W 85.62'
Kent County Monument (W 1/4 cor. Sec. 7, 6-11) S 00° E 32.30'

The selected location is accepted by me and is generally accepted by professional surveyors as the best available evidence of the position of the original corner.

C. Description of monument for corner and accessories established to perpetuate locating the position of the corner:

M-4 Standard Kent County Monument
"V" face light pole N 40° W 50.60'
SE cor. brick bldg. @ back of walk N 90° W 44.22'
NE cor. brick bldg. S 60° W 61.11'
SE cor. brick bldg. S 40° W 85.62'
Kent County Monument (W 1/4 cor. Sec. 7, 6-11) S 00° E 32.30'

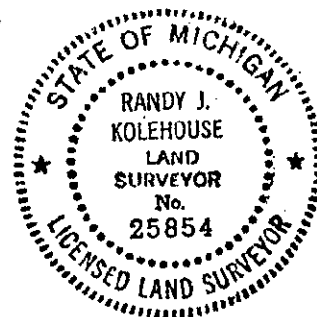

Signed by *Randy J. Kolehouse*
Surveyor's Michigan License No. 25854

Date 11/21/94