

SURVEY & REMONUMENTATION

APR 28 1995

Kent County Remonumentation

STATE OF MICHIGAN
COUNTY OF KENT
RECEIVED FOR RECORD

COMMISSION

LAND CORNER RECORDATION CERTIFICATE
Filing Requirement of Act 74, Mich. P.A. 1970

NOV 29 AM 9:25

For corners in
Kent

(County)	Located In:	Corner Code #
1. Public Land Survey	T <u>6N</u> R <u>12W</u>	<u>M-5</u>
	T _____ R _____	_____
	T _____ R _____	_____
	T _____ R _____	_____
2. Property Controlling in Section	S _____ T _____ R _____	_____
	S _____ T _____ R _____	_____
3. Miscellaneous Property in Sec.	S _____ T _____ R _____	_____
	S _____ T _____ R _____	_____

W. J. Bond
REG. OF DEEDS

7505

Register of Deeds Stamp & File Number

4. Lot No. _____, Recorded Plat _____
5. Private Claims _____

	A	B	C	D	E	F	G	H	I	J	K	L	M
2	6	5	4	3	2	1							
3													
4	7	8	9	10	11	12							
5													
6	18	17	16	15	14	13							
7													
8	19	20	21	22	23	24							
9													
10	30	29	28	27	26	25							
11													
12	31	32	33	34	35	36							
13													

I, Randy Kolehouse, in a field survey on July 19, 19 94, do hereby certify that under requirements of P.A. 74, Michigan P.A. of 1970, the corner points mentioned in lines 1 and 2 above were in conformance with regulations and rules therefore as required in the current manual of survey instructions of the United States Department of the Interior, Bureau of Land Management or by a decree of a Court of Law and/or that the corner points mentioned in lines 3, 4 and 5 above were in conformance with the rules of the Michigan Board of Land Surveyors or by a Decree of a Court of Law; established, re-established, monumented, re-monumented, recovered, found as expressed below:

NOTE: Not more than 4 corners, all in the same town and range, may be recorded on this certificate.

A. Description of original monument and accessories and/or subsequent restoration:

M-5	1831	G.L.O. Notes	L. Lyon	Set Post
	1920-1964	Survey Records	Williams & Works	"+" in Pavement
	1927	Wit. Map	K.C. Surveyor	"+" in Pavement
	1931	Survey Records	City of Grand Rapids	"+" in Pavement
	1984	L.C.R.C. #3975	William Byl	Set K.C. Mon.
	1988	L.C.R.C. #4742	Bueche	K.C. Mon.

P.A. 345 1990 KENT COUNTY
PEER APPROVED 9/11/94
CHAIRMAN Harry Stedee

The position of this corner was previously approved by the Kent County Remonumentation Peer Group monumented by William R. Byl on 9/10/84 and was recorded per L.C.R.C. #3975.

B. Description of corner evidence found and/or method applied in restoring or reestablishing corner:

M-5 Found K.C. Monument in C/L of Division Avenue N-S 17.4' M/L North of C/L 28th Street E-W per L.C.R.C.'s #3975 and #4742 as set by William Byl 46.2' North of the NW corner Section 18, T6N, R11W, per survey records of the City of Grand Rapids, Williams & Works and MDOT.

L.C.R.C. #4742

L.C.R.C. #3975


Capped iron N 50° E 58.82'
Capped iron N 53° W 67.39'
Harrison Monument (A-5) S 00° E 46.20'

Capped iron N 50° E 58.82'
Capped iron N 53° W 67.39'
Harrison Monument (A-5) S 00° E 46.20'

The selected location is accepted by me and is generally accepted by professional surveyors as the best available evidence of the position of the original corner.

C. Description of monument or corner and accessories established to perpetuate locating the position of the corner:

M-5 Set Standard Kent County Monument.
Capped iron N 50° E 58.82'
Capped iron N 53° W 67.39'
Harrison Monument (A-5) S 00° E 46.20'
PK nail & K.C. remon. tag S 45° W 82.50'

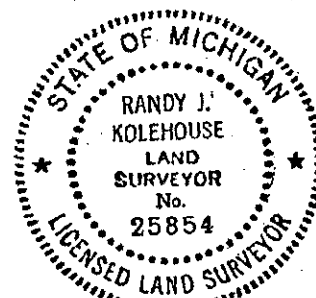

Signed by *Randy J. Kolehouse*
Surveyor's Michigan License No. 25854

Date 11/21/94