

SURVEY & REMONUMENTATION

Kent County Remonumentation

APR 28 1995

STATE OF MICHIGAN
COUNTY OF KENT
RECEIVED FOR RECORD

COMMISSION LAND CORNER RECORDATION CERTIFICATE 94 NOV 29 AM 9:25
Filing Requirement of Act 74, Mich. P.A. 1970

For corners in Kent

(County)	Located In:	Corner Code -#
1. Public Land Survey	T <u>6N</u> R <u>12W</u>	<u>M-6</u>
	T _____ R _____	_____
	T _____ R _____	_____
	T _____ R _____	_____
2. Property Controlling in Section	S _____ T _____ R _____	_____
	S _____ T _____ R _____	_____
3. Miscellaneous Property in Sec.	S _____ T _____ R _____	_____
	S _____ T _____ R _____	_____

W. J. Bond
REG. OF DEEDS

7506

Register of Deeds Stamp & File Number

4. Lot No. _____, Recorded Plat _____
5. Private Claims _____

	A	B	C	D	E	F	G	H	I	J	K	L	M
2	6	5	4	3	2	1							
3													
4	7	8	9	10	11	12							
5													
6	18	17	16	15	14	13							
7													
8	19	20	21	22	23	24							
9													
10	30	29	28	27	26	25							
11													
12	31	32	33	34	35	36							
13													

I, Randy Kolehouse, in a field survey on March 29, 19 94, do hereby certify that under requirements of P.A. 74, Michigan P.A. of 1970, the corner points mentioned in lines 1 and 2 above were in conformance with regulations and rules therefore as required in the current manual of survey instructions of the United States Department of the Interior, Bureau of Land Management or by a decree of a Court of Law and/or that the corner points mentioned in lines 3, 4 and 5 above were in conformance with the rules of the Michigan Board of Land Surveyors or by a Decree of a Court of Law; established, re-established, monumented, re-monumented, recovered, found as expressed below:

NOTE: Not more than 4 corners, all in the same town and range, may be recorded on this certificate.

A. Description of original monument and accessories and/or subsequent restoration:

M-6	1831	G.L.O. Notes	L. Lyon	Set Post
	1904-1955	Survey Notes	Williams & Works	City Iron
	1953	Wit. Map	K.C. Surveyor	Iron in Mon. Box
	1976	L.C.R.C. #907	Exxel Engineering	Iron in Mon. Box
	1984	L.C.R.C. #3946	William Byl	Fnd. Iron in Mon. Box/Set K.C. Mon.
	1988	L.C.R.C. #4719	Bueche	K.C. Mon.

P.A. 345 1990 KENT COUNTY
PEER APPROVED 8/11/94
CHAIRMAN Henry Huber

The position of this corner was previously approved by the Kent County Remonumentation Peer Group monumented by William R. Byl on 4/12/84 and was recorded per L.C.R.C. #3946 and also recorded 3/2/88 per L.C.R.C. #4719.


B. Description of corner evidence found and/or method applied in restoring or reestablishing corner:

M-6	Found K.C. Monument in C/L of Division Avenue N-S and 32nd Street E-W per L.C.R.C.'s #3946 and #4719 as set by William Byl in place of a 1" iron in monument box which he found and checked with L.C.R.C. #907 and dist. to the W 1/4 corner, Section 18, T6N, R11W, per Williams & Works survey records.
	L.C.R.C. #3946
	C/L of S bolt traffic signal pole N 45° W 56.98'
	C/L of N bolt traffic signal pole S 45° E 71.34'
	C/L top of hyd. S 35° W 73.19'
	N'y SW cor. of bldg. #3158 N 50° E 96.15' (to face of wood veneer)
	Rerod & cap in mon. box S 00° W 27.76'
	L.C.R.C. #4719
	C/L of S bolt traffic signal pole N 45° W 56.98'
	C/L of N bolt traffic signal pole S 45° E 71.34'
	C/L top of hyd. S 35° W 73.19'
	N'y SW cor. of bldg. #3158 N 50° E 96.15' (to face of wood veneer)
	Rerod & cap in mon. box S 00° W 27.76'
	On C/L bit. N-S, C/L bit. W

The selected location is accepted by me and is generally accepted by professional surveyors as the best available evidence of the position of the original corner.

C. Description of monument for corner and accessories established to perpetuate locating the position of the corner:

M-6	Standard Kent County Monument
	C/L of S bolt traffic signal pole N 45° W 56.98'
	C/L of N bolt traffic signal pole S 45° E 71.34'
	C/L top of hyd. S 35° W 73.19'
	N'y SW cor. of bldg. #3158 N 50° E 96.15' (to face of wood veneer)
	Rerod & cap in mon. box S 00° W 27.76'

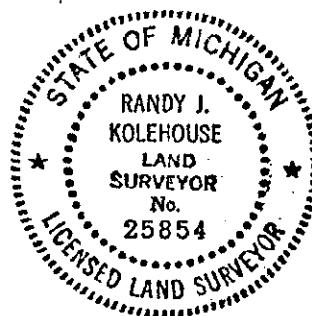

Signed by Randy J. Kolehouse
Surveyor's Michigan License No. 25854

Date 11/21/94