

**SURVEY & REMONUMENTATION**

APR 28 1995

Kent County Remonumentation

STATE OF MICHIGAN  
COUNTY OF KENT  
RECEIVED FOR RECORD

**COMMISSION LAND CORNER RECORDATION CERTIFICATE**  
Filing Requirement of Act 74, Mich. P.A. 1970

94 NOV 29 AM 9:26

*Lucy J. Dand*  
REG. OF DEEDS

7508

Register of Deeds Stamp & File Number

For corners in Kent (County)	Located In:	Corner Code #
1. Public Land Survey	T <u>6N</u> R <u>12W</u>	<u>M-8</u>
	T _____ R _____	_____
	T _____ R _____	_____
	T _____ R _____	_____
2. Property Controlling in Section	S _____ T _____ R _____	_____
	S _____ T _____ R _____	_____
3. Miscellaneous Property in Sec.	S _____ T _____ R _____	_____
	S _____ T _____ R _____	_____

4. Lot No. \_\_\_\_\_, Recorded Plat \_\_\_\_\_  
5. Private Claims \_\_\_\_\_

	A	B	C	D	E	F	G	H	I	J	K	L	M
2	6	5	4	3	2	1							
3													
4	7	8	9	10	11	12							
5													
6	18	17	16	15	14	13							
7													
8	19	20	21	22	23	24							
9													
10	30	29	28	27	26	25							
11													
12	31	32	33	34	35	36							
13													

I, Randy Kolehouse, in a field survey on May 16, 19 94, do hereby certify that under requirements of P.A. 74, Michigan P.A. of 1970, the corner points mentioned in lines 1 and 2 above were in conformance with regulations and rules therefore as required in the current manual of survey instructions of the United States Department of the Interior, Bureau of Land Management or by a decree of a Court of Law and/or that the corner points mentioned in lines 3, 4 and 5 above were in conformance with the rules of the Michigan Board of Land Surveyors or by a Decree of a Court of Law; established, re-established, monumented, re-monumented, recovered, found as expressed below:

**NOTE: Not more than 4 corners, all in the same town and range, may be recorded on this certificate.**

**A. Description of original monument and accessories and/or subsequent restoration:**

M-8	1831	G.L.O. Notes	L. Lyon	Set Post
	1909-1953	Survey Notes	Williams & Works	Stone/Iron in Mon. Box
	1980	Survey Records	City of Wyoming	Mon. Box
	1984	L.C.R.C. #3903	William Byl	Fnd. Iron in Mon. Box/Set K.C. Mon.
	1988	L.C.R.C. #4721	Bueche	K.C. Monument

P.A. 345 1990 KENT COUNTY,

PEER APPROVED 7/28/94  
*Harry Thibodeau*

This corner was originally approved by the Kent County Remonumentation Peer Group and monumented by William Byl on 9/84 and was recorded per L.C.R.C. #3903.

**B. Description of corner evidence found and/or method applied in restoring or reestablishing corner:**

M-8 Found K.C. Monument in C/L of Division Avenue N-S per L.C.R.C.'s #3903 and #4721 as set by William Byl in place of an iron in monument box which he found and checked using Williams & Works survey records and City of Wyoming survey records.

L.C.R.C. #3903

NW cor. porch fndn. hse. #4006 N 60° E 60.60'  
NW cor. brick bldg. #4000 N 30° E 118.48'  
SW cor. conc. step. hse. #4010 N 90° E 49.70'  
NW cor fndn. hse. #4014 S 60° E 71.08'  
C/L top of hydt. S 40° W 54.31'  
K.C. mon. (W 1/4 cor. Sec. 19, 6-11) S 00° E 22.32'


L.C.R.C. #4721

NW cor. porch fndn. hse. #4006 N 60° E 60.60'  
NW cor. brick bldg. #4000 N 30° E 118.48'  
SW cor. conc. step. hse. #4010 N 90° E 49.70'  
NW cor fndn. hse. #4014 S 60° E 71.08'  
C/L top of hydt. S 40° W 54.31'  
K.C. mon. (W 1/4 cor. Sec. 19, 6-11) S 00° E 22.32'  
PK N 0.96' & E 1.00'

The selected location is accepted by me and is generally accepted by professional surveyors as the best available evidence of the position of the original corner.

**C. Description of monument for corner and accessories established to perpetuate locating the position of the corner:**

M-8 Standard Kent County Monument  
NW cor. porch fndn. hse. #4006 N 60° E 60.60'  
NW cor. brick bldg. #4000 N 30° E 118.48'  
SW cor. conc. step. hse. #4010 N 90° E 49.70'  
NW cor fndn. hse. #4014 S 60° E 71.08'  
C/L top of hydt. S 40° W 54.31'  
K.C. mon. (W 1/4 cor. Sec. 19, 6-11) S 00° E 22.32'

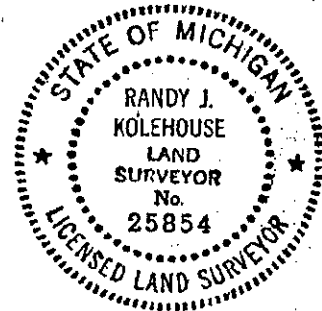

Signed by *Randy J. Kolehouse*  
Surveyor's Michigan License No. 25854

Date 11/21/94