


# GOVERNMENT SURVEY CORNER NUMBERING CODE DIAGRAM

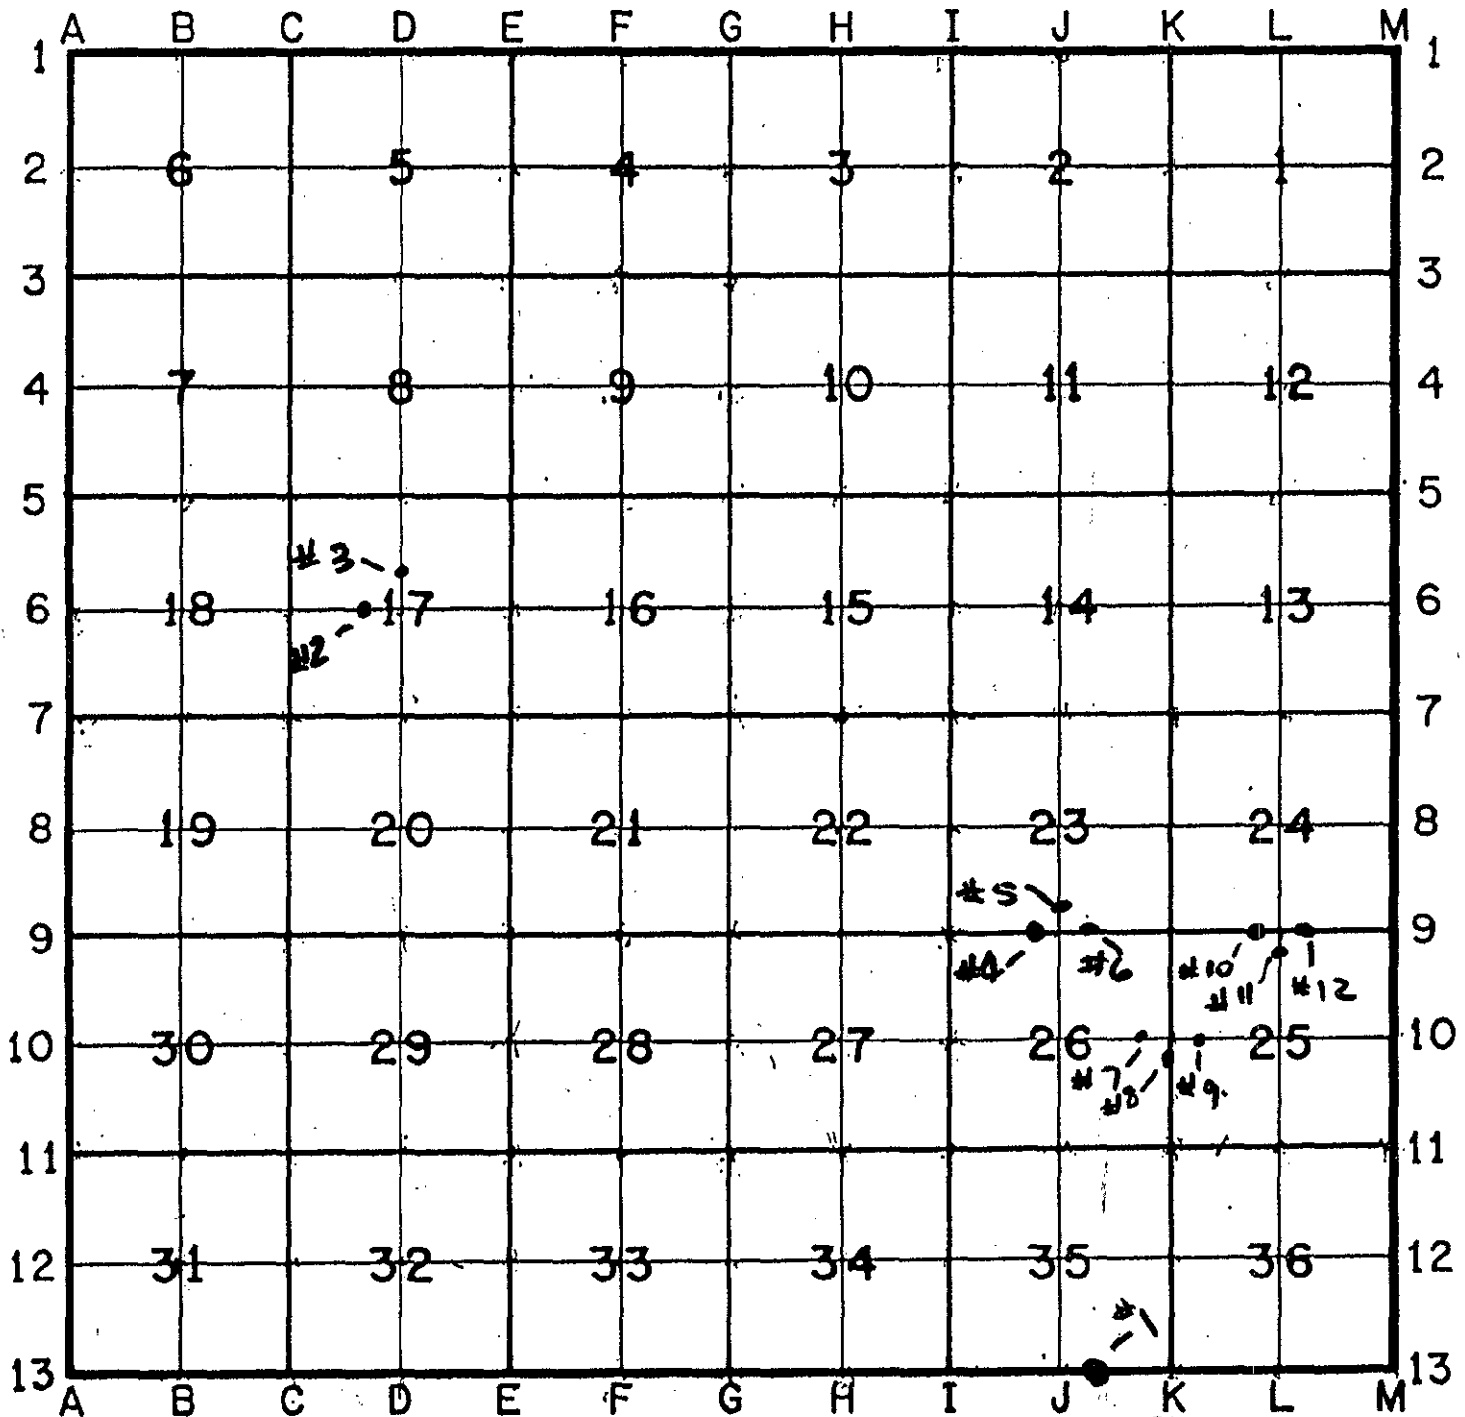

T7N R9W  
Kent Co. Vergennes Twp

SURVEY &  
REMONUMENTATION

MAR 01 1999

SECTION