

SURVEY & REMONUMENTATION

\$7.00
\$2.00

MAR 03 1998

SECTION

LAND CORNER RECORDATION CERTIFICATE
Filing Requirement of Act 74, Mich. P.A. 1970
KENT COUNTY REMONUMENTATION

For corners in

Kent (County)	Located in: Vergennes Township	Corner Code #
1. Public Land Survey	T <u>7N</u> R <u>9W</u>	<u>A-2</u>
	T _____ R _____	_____
	T _____ R _____	_____
	T _____ R _____	_____
2. Property Controlling in Section	S _____ T _____ R _____	_____
	S _____ T _____ R _____	_____
3. Miscellaneous Property in Sec.	S _____ T _____ R _____	_____
	S _____ T _____ R _____	_____


STATE OF MICHIGAN
COUNTY OF KENT
RECEIVED FOR RECORD
97 NOV 14 AM 8:59
REG. OF DEEDS
Lucy Bond

10284

Register of Deeds Stamp & File Number

- 4. Lot No. _____, Recorded Plat _____
- 5. Private Claims _____

I, Randy Kolehouse, in a field survey on June 5 19 97, do hereby certify that under requirements of P.A. 74 Michigan P.A. of 1970, the corner points mentioned in lines 1 and 2 above were in conformance with regulations and rules therefore as required in the current manual of survey instructions of the United States Department of the interior, Bureau of Land Management or by a decree of a Court of Law and/or that the corner points mentioned in lines 3, 4 and 5 above were in conformance with the rules of the Michigan Board of Land Surveyors or by a Decree of a Court of Law; established, re-established, monumented, re-monumented, recovered, found as expressed below:

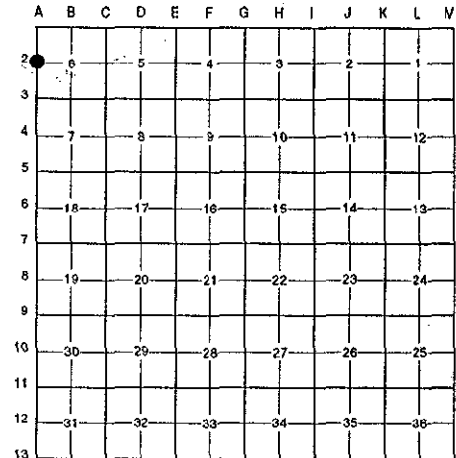

NOTE: Not more than 4 corners, all in the same town and range, may be recorded on this certificate.

A. Description of original monument and accessories and/or subsequent restoration:

A-2	1831	G.L.O. Notes	Mullett	Set Post
	1980	L.C.R.C. #1370	Mederna, Van Kooten & Assoc.	"T" Iron
	1982	L.C.R.C. #3161	Williams & Works	Fnd. "T" Iron / Set K.C. Monument
	1991	L.C.R.C. #5818	Exxel Engineering	K.C. Monument
	1994	L.C.R.C. #8047	Glaza & Associates	K.C. Monument

Note: This corner is common with M-2, T7N, R10W.

This corner was originally approved by the Kent County Remonumentation Peer Group and monumented by Williams & Works on 11/22/82 and was recorded per L.C.R.C. #3161.

P.A. 345 1990 KENT COUNTY
PEER APPROVED 8/28/97
CHAIRMAN Walter Habel

B. Description of corner evidence found and/or method applied in restoring or reestablishing corner:

A-2 Found a broken Standard Kent County Monument 5' ± West of the C/L of Boynton Avenue (gravel) running North and South and 3' North of a fence line and tree row running East per L.C.R.C.'s #3161, #5818, and #8047 as set by Williams & Works in place of a T" iron they found which checked L.C.R.C. #1370 and the K.C. Surveyor's records.

L.C.R.C. #3161

L.C.R.C. #8047

- Nail & KC Remon tag in NW side 14" Wild Cherry N 35° E 40.08'
- Nail & KC Remon tag in S side 6" Wild Cherry S 85° E 23.91'
- Nail & KC Remon tag in NE side 12" Elm 65° W 19.76'
- Nail & KC Remon tag in SE side 16" Maple S 65° W 59.90'


- Nail & K.C. remon tag in NW side 16" W. Cherry N 35° E 40.09' (m. 40.10')
- Nail & K.C. remon tag in NE side 18" Elm N 61° W 19.38' (m. 19.45')
- Nail & K.C. remon tag in S side 10" W. Cherry S 85° E 24.02' (m. 23.94')
- Nail & K.C. remon tag in SE side 32" Maple S 51° W 59.67' (m. 59.71')

The selected location is accepted by me and is generally accepted by professional surveyors as the best available evidence of the position of the original corner.

C. Description of monument for corner and accessories established to perpetuate locating the position of the corner:

A-2 Reset a Standard Kent County Monument

- Nail & K.C. remon. tag on NW side 16" W. Cherry N 35° E 40.10'
- Nail & K.C. remon. tag on NE side 18" Elm N 61° W 19.45'
- Nail & K.C. remon. tag on S side 10" W. Cherry S 85° E 23.94'
- Nail & K.C. remon. tag on SE side 24" Maple S 51° W 59.71'

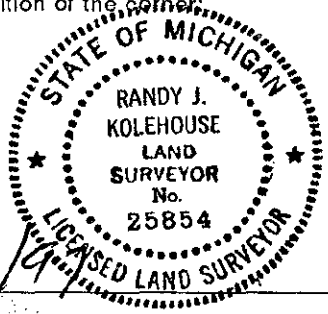

Signed by Randy J. Kolehouse Date 9/23/97
EARTH TECH

Surveyor's Michigan License No. 25854