

**SURVEY & REMONUMENTATION**

MAR 03 1998

\$7.00  
\$2.00

**LAND CORNER RECORDATION CERTIFICATE**  
Filing Requirement of Act 74, Mich. P.A. 1970  
KENT COUNTY REMONUMENTATION

For corners in


Kent (County)	Located in: Vergennes Township	Corner Code #
1. Public Land Survey	T <u>7N</u> R <u>9W</u>	<u>A-3</u>
	T _____ R _____	_____
	T _____ R _____	_____
	T _____ R _____	_____
2. Property Controlling in Section	S _____ T _____ R _____	_____
	S _____ T _____ R _____	_____
3. Miscellaneous Property in Sec.	S _____ T _____ R _____	_____
	S _____ T _____ R _____	_____

STATE OF MICHIGAN  
COUNTY OF KENT  
RECEIVED FOR RECORD  
97 NOV 14 AM 8:59  
REG. OF DEEDS  
*Luci Spand*

**10285**  
Register of Deeds Stamp & File Number

- 4. Lot No. \_\_\_\_\_, Recorded Plat \_\_\_\_\_
- 5. Private Claims \_\_\_\_\_

I, Randy Kolehouse, in a field survey on June 3 19 97, do hereby certify that under requirements of P.A. 74 Michigan P.A. of 1970, the corner points mentioned in lines 1 and 2 above were in conformance with regulations and rules therefore as required in the current manual of survey instructions of the United States Department of the interior, Bureau of Land Management or by a decree of a Court of Law and/or that the corner points mentioned in lines 3, 4 and 5 above were in conformance with the rules of the Michigan Board of Land Surveyors or by a Decree of a Court of Law; established, re-established, monumented, re-monumented, recovered, found as expressed below:

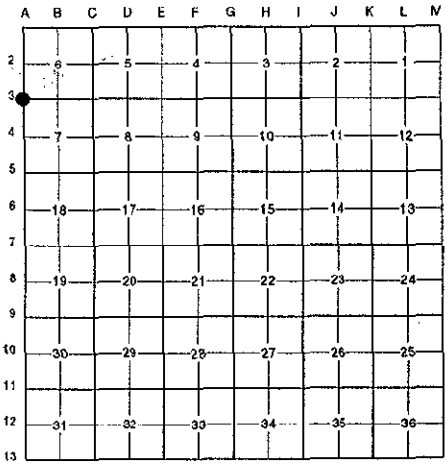

**NOTE: Not more than 4 corners, all in the same town and range, may be recorded on this certificate.**

**A. Description of original monument and accessories and/or subsequent restoration:**

Date	Description	Surveyor	Monument
1831	G.L.O. Notes	Mullett	Set Post
1940	Witness Map	K.C. Surveyor	Concrete Monument
1980	L.C.R.C. #1370	Medema, Van Kooten & Assoc.	"T" Iron
1982	L.C.R.C. #3160	Williams & Works	Fnd. "T" Iron / Set K.C. Monument
1991	L.C.R.C. #5819	Exxel Engineering	K.C. Monument
1994	L.C.R.C. #8048	Glaza & Associates	K.C. Monument

P.A. 345 1990 KENT COUNTY  
PEER APPROVED 8/28/97

Note: This corner is common with M-3, T7N, R10W.

This corner was originally approved by the Kent County Remonumentation Peer Group and ~~CHANGED~~ by Williams & Works on 11/22/82 and was recorded per L.C.R.C. #3160.

*Harry Huber*

**B. Description of corner evidence found and/or method applied in restoring or reestablishing corner:**

A-3 Found a Standard Kent County Monument (0.4' below grade) on the C/L of 3 Mile Road (gravel) running East and West and 5' West of the C/L of Boynton Avenue (gravel) running North per L.C.R.C.'s #3160, #5819, #8048 as set by Williams & Works in place of a "T" iron they found which checked L.C.R.C. #1370 and the K.C. Surveyor's records.

L.C.R.C. #3160

L.C.R.C. #8048

- Nail & KC Remon tag in SE side 28" Hickory N 45° E 54.96'
- Nail & KC Remon tag in E side 18" Walnut N 25° W 66.33'
- Nail & KC Remon tag in S side 12" Oak S 70° W 70.65'
- Nail & KC Remon tag in NW side 6" Maple S 45° W 33.12'
- Nail & KC Remon tag in NE side 12" Hickory S 30° E 31.25'
- Center line of road running North is 5' East of corner


- Nail & K.C. remon tag in SE side 30" Hickory N 45° E 54.95' (m. 54.96')
- Nail & K.C. remon tag in E side 24" Walnut N 21° W 66.33'
- Nail & K.C. remon tag in NW side 12" Maple S 45° W 33.12'
- Nail & K.C. remon tag in SE side 14" Hickory S 74° W 70.51'
- C/L of road running N is 5' E of corner

The selected location is accepted by me and is generally accepted by professional surveyors as the best available evidence of the position of the original corner.

**C. Description of monument for corner and accessories established to perpetuate locating the position of the corner:**

A-3 Standard Kent County Monument

- Nail & K.C. remon. tag on SE side 30" Hickory N 45° E 54.96'
- Nail & K.C. remon. tag on E side 24" Walnut N 25° W 66.33'
- Nail & K.C. remon. tag on NW side 12" Maple S 45° W 33.12'
- Nail & K.C. remon. tag on S side 14" Hickory S 70° W 70.65'

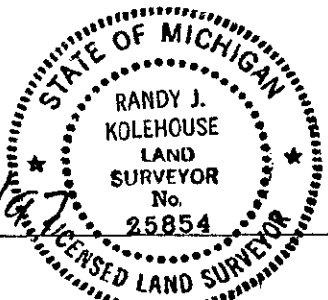

Signed by *Randy J. Kolehouse*  
EARTH TECH

Date 9/23/97

Surveyor's Michigan License No. 25854