

SURVEY & REMONUMENTATION

MAR 03 1998

\$7.00
\$2.00

SECTION LAND CORNER RECORDATION CERTIFICATE Filing Requirement of Act 74, Mich. P.A. 1970 KENT COUNTY REMONUMENTATION

For corners in


| | | |
|---------------------------------------|-----------------------------------|----------------------|
| Kent <small>(County)</small> | Located in: Vergennes Township | Corner Code # A-5 |
| 1. Public Land Survey | T <u>7N</u> R <u>9W</u> | <u>A-5</u> |
| | T _____ R _____ | _____ |
| | T _____ R _____ | _____ |
| | T _____ R _____ | _____ |
| 2. Property Controlling in Section | S _____ T _____ R _____ | _____ |
| | S _____ T _____ R _____ | _____ |
| 3. Miscellaneous Property in Sec. | S _____ T _____ R _____ | _____ |
| | S _____ T _____ R _____ | _____ |
| 4. Lot No. _____, Recorded Plat _____ | | |
| 5. Private Claims _____ | | |

STATE OF MICHIGAN
 COUNTY OF KENT
 RECEIVED FOR RECORD
 97 NOV 14 AM 8:59
 REG. OF DEEDS
Lucy St. Paul

10287

Register of Deeds Stamp & File Number

I, Randy Kolehouse, in a field survey on June 3 19 97, do hereby certify that under requirements of P.A. 74 Michigan P.A. of 1970, the corner points mentioned in lines 1 and 2 above were in conformance with regulations and rules therefore as required in the current manual of survey instructions of the United States Department of the interior, Bureau of Land Management or by a decree of a Court of Law and/or that the corner points mentioned in lines 3, 4 and 5 above were in conformance with the rules of the Michigan Board of Land Surveyors or by a Decree of a Court of Law; established, re-established, monumented, re-monumented, recovered, found as expressed below:

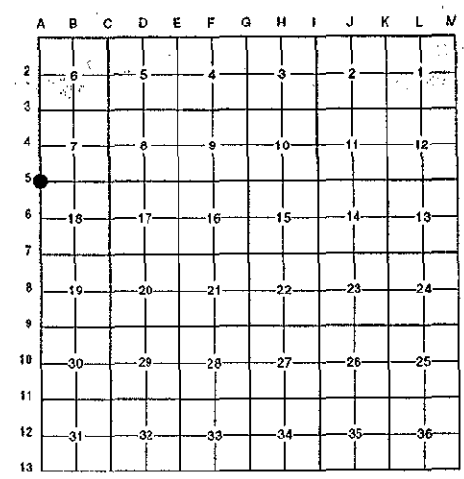

NOTE: Not more than 4 corners, all in the same town and range, may be recorded on this certificate.

A. Description of original monument and accessories and/or subsequent restoration:

| | | | |
|-----|---------------------|---------------------|--|
| A-5 | 1831 G.L.O. Notes | Mullett | Set Post |
| | 1938 Witness Map | K.C. Surveyor | Stone |
| | 1961 Witness Map | K.C. Surveyor | Stone |
| | 1972 L.C.R.C. #465 | Williams & Works | "T" Iron (M-5, T7N, R10W) |
| | 1981 L.C.R.C. #1916 | Jonker Land Surveys | Fnd. "T" Iron / Set K.C. Monument (M-5, T7N, R10W) |
| | 1991 L.C.R.C. #5821 | Exxel Engineering | K.C. Monument |
| | 1994 L.C.R.C. #8050 | Glaza & Associates | K.C. Monument (M-5, T7N, R10W) |

P.A. 345 1990 KENT COUNTY
 PEER APPROVED 2/20/97
 CHAIRMAN Randy Kolehouse

Note: This corner is common with M-5, T7N, R10W.

This corner was originally approved by the Kent County Remonumentation Peer Group and monumented by Rob Jonker on 7/16/81 and was recorded per L.C.R.C. #1916.

B. Description of corner evidence found and/or method applied in restoring or reestablishing corner:

A-5 Found a Standard Kent County Monument 6.5' North of the C/L of 2 Mile Road (bit.) running East and West per L.C.R.C.'s #1916, #5821 and #8050 as set by Rob Jonker in place of a "T" iron he found over a 3/4" rd. iron 24" below grade which checked L.C.R.C. #465 and the K.C. Surveyor's records.

| | |
|--|---|
| L.C.R.C. #1916 | L.C.R.C. #8050 |
| Remon. tag on NE side 24" Maple S 53° E 74.98' | K.C. remon tag & nail in E side 16" Maple S 05° W 58.88' |
| Remon. tag on E side 14" Maple S 02° W 58.58' | K.C. remon tag & nail in N side fence post N 59° E 45.44' |
| Remon. tag on N side fe. post N 54° E 45.43' | K.C. remon tag & nail in NE side 18" Ash S 39° E 91.43' |
| | K.C. remon tag & nail in E side 8" Elm N 22° E 22.50' |

The selected location is accepted by me and is generally accepted by professional surveyors as the best available evidence of the position of the original corner.

C. Description of monument for corner and accessories established to perpetuate locating the position of the corner:

- A-5 Standard Kent County Monument
- Nail & K.C. remon. tag on NW side 16" Maple S 05° W 58.88'
 - Nail & K.C. remon. tag on N side fence post N 59° E 45.44'
 - Nail & K.C. remon. tag on NE side 18" Ash S 39° E 91.43'
 - Nail & K.C. remon. tag on E side 8" Elm N 22° E 22.50'



Signed by Randy J. Kolehouse Date 9/23/97
 EARTH TECH

Surveyor's Michigan License No. 25854