SURVEY & REMONUMENTATION

MAR 0 3 1998

$7.00
$2.00

SECTION

# LAND CORNER RECORDATION CERTIFICATE

**Filing Requirement of Act 74, Mich. P.A. 1970**

KENT COUNTY REMONUMENTATION

STATE OF MICHIGAN
COUNTY OF KENT
RECEIVED FOR RECORD
97 NOV 14 AM 9:00
REG. OF DEEDS

10293

**Register of Deeds Stamp & File Number**

For corners in Kent (County) Located in: Vergennes Township Corner Code #

1. Public Land Survey T 7N R 9W A-11
   T ____ R ____
   T ____ R ____
   T ____ R ____
2. Property Controlling S ____ T ____ R ____
   in Section S ____ T ____ R ____
3. Miscellaneous S ____ T ____ R ____
   Property in Sec. S ____ T ____ R ____

4. Lot No. ____, Recorded Plat ____
5. Private Claims ____

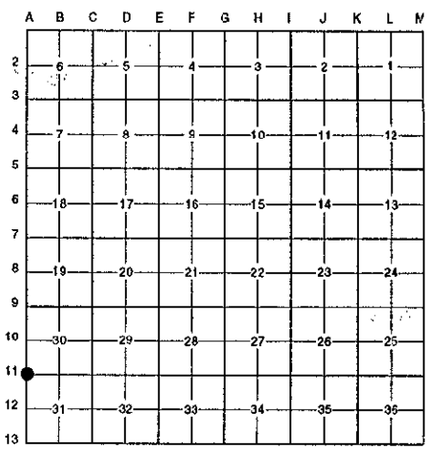


I, Randy Kolehouse, in a field survey on January 29 19 97, do hereby certify that under requirements of P.A. 74 Michigan P.A. of 1970, the corner points mentioned in lines 1 and 2 above were in conformance with regulations and rules therefore as required in the current manual of survey instructions of the United States Department of the interior, Bureau of Land Management or by a decree of a Court of Law and/or that the corner points mentioned in lines 3, 4 and 5 above were in conformance with the rules of the Michigan Board of Land Surveyors or by a Decree of a Court of Law; established, re-established, monumented, re-monumented, recovered, found as expressed below:

**NOTE: Not more than 4 corners, all in the same town and range, may be recorded on this certificate.**

P.A. 345 1990 KENT COUNTY
PEER APPROVED 8/28/97
CHAIRMAN Harry Kuhne

A. Description of original monument and accessories and/or subsequent restoration:

| | | | | |
|---|---|---|---|---|
| A-11 | 1831 | G.L.O. Notes | Mullett | Set Post |
| | 1932-56 | Witness Map | K.C. Surveyor | Iron |
| | 1972 | L.C.R.C. #245 | Williams & Works | Boat Spike (M-11, T7N, R10W) |
| | 1975 | L.C.R.C. #919 | McCombs | Boat Spike |
| | 1981 | L.C.R.C. #1922 | Jonker Land Surveys | Fnd. Boat Spike & Iron / Set K.C. Monument (M-11, T7N, R10W) |
| | 1991 | L.C.R.C. #5827 | Exxel Engineering | K.C. Monument |
| | 1994 | L.C.R.C. #8056 | Glaza & Associates | K.C. Monument (M-11, T7N, R10W) |

Note: This corner is common with M-11, T7N, R10W.

This corner was originally approved by the Kent County Remonumentation Peer Group and monumented by Rob Jonker and was recorded per L.C.R.C. #1922.

B. Description of corner evidence found and/or method applied in restoring or reestablishing corner:

A-11 Found a Standard Kent County Monument at the intersection of Vergennes Street (bit.) running East and West and Boynton Avenue running North and South per L.C.R.C.'s #1922, #5827 and #8056 as set by Rob Jonker in place of a boat spike he found at grade over a 3/4" iron 1' below grade which checked L.C.R.C.'s #919, #245, and the K.C. Surveyor's records.

| L.C.R.C. #1922 | L.C.R.C. #8056 |
|---|---|
| Remon. tag on E side P. Pole N 31° E 68.89' | K.C. remon tag & nail in E side P. pole N 31° E 68.03' |
| Remon. tag on NW side T. pole S 38° W 51.20' | K.C. remon tag & nail in S side T. pole S 67° W 104.88' (104.89') |
| Remon. tag on S side t. pole S 69° W 105.43" | K.C. remon tag & nail in N side 14" Oak S 74° E 140.78' (140.76') |
| Remon. tag on N side 12" Oak S 74° E 141.09' | K.C. remon tag & nail in NW side 14" Oak N 43° W 115.20' |
| SE corner school N 43° W 115.2' | SE corner of school |
| C/L pavement S 3' m/l | On C/L pavement |

The selected location is accepted by me and is generally accepted by professional surveyors as the best available evidence of the position of the original corner.

C. Description of monument for corner and accessories established to perpetuate locating the position of the corner:

A-11 Standard Kent County Monument

Nail & K.C. remon. tag on E side P. pole N 30° E 68.03'
Nail & K.C. remon. tag on S side T. pole S 67° W 104.89'
Nail & K.C. remon. tag on N side 14" Oak S 74° E 140.76'
Nail & K.C. remon. tag on NW side 14" Oak S 38° W 54.77'
SE cor. school N 43° W 115.20'

STATE OF MICHIGAN
RANDY J. KOLEHOUSE
LAND SURVEYOR
No. 25854
LICENSED LAND SURVEYOR

Signed by Randy J. Kolehouse Date 9/23/97
EARTH TECH

Surveyor's Michigan License No. 25854

FORM APPROVED BY MICHIGAN STATE BOARD OF LAND SURVEYORS, JAN. 28, 1971
REVISED MAY 14, 1975
REVISED JAN., 1983