

**SURVEY & REMONUMENTATION**  
 \$7.00  
 \$2.00  
 MAR 08 1999

**LAND CORNER RECORDATION CERTIFICATE**  
**Filing Requirement of Act 74, Mich. P.A. 1970**  
**KENT COUNTY REMONUMENTATION**


For corners in SECTION  
Kent (County) Located in: Vergennes Township Corner Code #

1. Public Land Survey	T <u>7N</u> R <u>9W</u>	<u>B-1</u>
	T _____ R _____	_____
	T _____ R _____	_____
	T _____ R _____	_____
2. Property Controlling in Section	S _____ T _____ R _____	_____
	S _____ T _____ R _____	_____
3. Miscellaneous Property in Sec.	S _____ T _____ R _____	_____
	S _____ T _____ R _____	_____

4. Lot No. \_\_\_\_\_, Recorded Plat \_\_\_\_\_  
 5. Private Claims \_\_\_\_\_

STATE OF MICHIGAN  
 COUNTY OF KENT  
 RECEIVED FOR RECORD  
 38 OCT 23 AM 9:55  
 REG. OF DEEDS  
*W. J. Kolehous*  
**10730**  
 Register of Deeds Stamp & File Number

I, Randy Kolehous, in a field survey on December 31 19 97, do hereby certify that under requirements of P.A. 74 Michigan P.A. of 1970, the corner points mentioned in lines 1 and 2 above were in conformance with regulations and rules therefore as required in the current manual of survey instructions of the United States Department of the interior, Bureau of Land Management or by a decree of a Court of Law and/or that the corner points mentioned in lines 3, 4 and 5 above were in conformance with the rules of the Michigan Board of Land Surveyors or by a Decree of a Court of Law; established, re-established, monumented, re-monumented, recovered, found as expressed below:

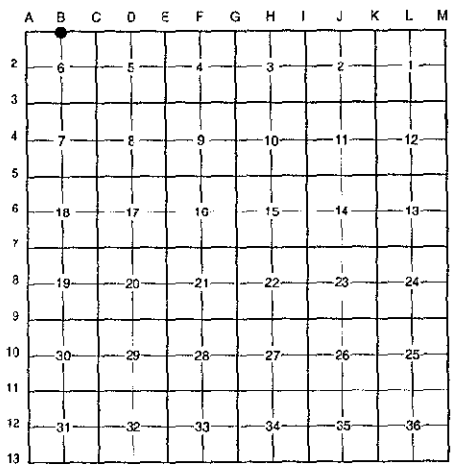

**NOTE: Not more than 4 corners, all in the same town and range, may be recorded on this certificate.**

- A. Description of original monument and accessories and/or subsequent restoration:
- B-1 This corner was not originally set by the G.L.O.
  - 1989 L.C.R.C. #5168 R. Kolehous Set Point on Town Line / Set K.C. Monument
  - 1994 L.C.R.C. #7975 Glaza & Associates K.C. Monument (moved)
  - 1995 L.C.R.C. #8223 William Byl Reset K.C. Monument

Note: This corner is not common with B-13, T8N, R9W.

This corner was originally approved by the Kent County Remonumentation Peer Group and monumented by R. Kolehous on 5/31/89 and was recorded per L.C.R.C. #5168. Later moved and reset by William Byl on 2/23/95 and recorded per L.C.R.C. #8223.

- B. Description of corner evidence found and/or method applied in restoring or reestablishing corner:
- B-1 Found a Standard Kent County Monument 60.0' ± East of the C/L of a gravel drive running North and South, on line of a tree row running East, and 15.0' West of a tree row running South per L.C.R.C. #8223. Originally set by Randy Kolehous and later reset by William Byl 115.56' East of B-13.


L.C.R.C. #8223

- Nail & K.C. remon. tag on S. side 10" Cherry S 60° E 17.04'
- Nail & K.C. remon. tag on S. side 10" Hickory N 85° E 34.37'
- Nail & K.C. remon. tag on S. side Tw. 8" Hickory N 75° W 20.90'
- Nail & K.C. remon. tag on NE side 14" Hickory S 20° E 27.66'

P.A. 345 1990 KENT COUNTY  
 PEER APPROVED 2/19/98  
 CHAIRMAN *Harry Hubers*

The selected location is accepted by me and is generally accepted by professional surveyors as the best available evidence of the position of the original corner.

- C. Description of monument for corner and accessories established to perpetuate locating the position of the corner:
- B-1 Standard Kent County Monument
  - Nail & K.C. remon. tag on S face 10" Cherry S 60° E 17.04'
  - Nail & K.C. remon. tag on S face 10" Hickory N 85° E 34.41'
  - Nail & K.C. remon. tag on S face twin 8" Hickory N 75° W 20.84'
  - Nail & K.C. remon. tag on NE face 14" Hickory S 20° E 27.68'
  - C/L of gravel drive running N-S, West 60.0'
  - On tree row running E
  - Tree row running S, East 15.0'
  - K.C. Mon., B-13, T8N, R9W, West 115.50'

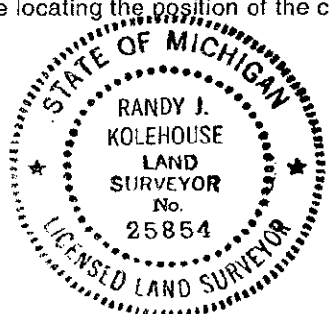

Signed by *Randy J. Kolehous* Date 9-1-98  
 EARTH TECH

Surveyor's Michigan License No. 25854