

MAR 6 8 1999

SECTION

\$7.00
\$2.00

LAND CORNER RECORDATION CERTIFICATE
Filing Requirement of Act 74, Mich. P.A. 1970
KENT COUNTY REMONUMENTATION

For corners in

Kent (County)	Located in: Vergennes Township	Corner Code #
1. Public Land Survey	T <u>7N</u> R <u>9W</u>	<u>B-3</u>
	T _____ R _____	_____
	T _____ R _____	_____
	T _____ R _____	_____
2. Property Controlling in Section	S _____ T _____ R _____	_____
	S _____ T _____ R _____	_____
3. Miscellaneous Property in Sec.	S _____ T _____ R _____	_____
	S _____ T _____ R _____	_____

REG. OF DEEDS

Handwritten signature


98 OCT 23 AM 9:55

STATE OF MICHIGAN
COUNTY OF KENT
RECEIVED FOR RECORD

10731

Register of Deeds Stamp & File Number

- 4. Lot No. _____, Recorded Plat _____
- 5. Private Claims _____

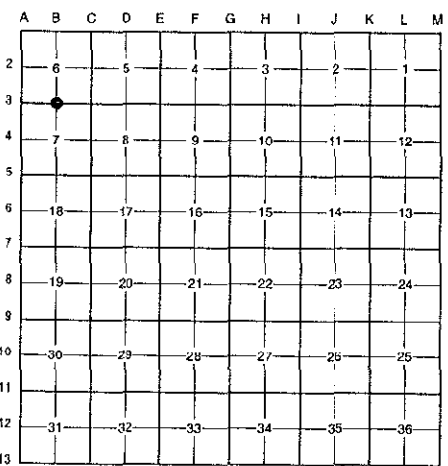

I, Randy Kolehouse, in a field survey on December 29 19 97, do hereby certify that under requirements of P.A. 74 Michigan P.A. of 1970, the corner points mentioned in lines 1 and 2 above were in conformance with regulations and rules therefore as required in the current manual of survey instructions of the United States Department of the interior, Bureau of Land Management or by a decree of a Court of Law and/or that the corner points mentioned in lines 3, 4 and 5 above were in conformance with the rules of the Michigan Board of Land Surveyors or by a Decree of a Court of Law; established, re-established, monumented, re-monumented, recovered, found as expressed below:

NOTE: Not more than 4 corners, all in the same town and range, may be recorded on this certificate.

A.	Description of original monument and accessories and/or subsequent restoration:
B-3	1838 G.L.O. Notes N. Brookfield Set Post N/A Witness Map K.C. Surveyor Stone 1980 L.C.R.C. #1370 Medema, Van Kooten & Assoc. Iron 1981 L.C.R.C. #1905 Jonker Land Survey Fnd. 1" Round Iron / Set K.C. Monument 1991 L.C.R.C. #5811 Exxel Engineering K.C. Monument

P.A. 345 1990 KENT COUNTY
PEER APPROVED 2/19/98
CHAIRMAN [Signature]

This corner was originally approved by the Kent County Remonumentation Peer Group and monumented by Rob Jonker on 7/14/81 and was recorded per L.C.R.C. #1905.


- B. Description of corner evidence found and/or method applied in restoring or reestablishing corner:
- B-3 Found a Standard Kent County Monument on the C/L of 3 Mile Road (gravel) running East and West, 5' East of a fence line running South, per L.C.R.C.'s #1905 and #5811 as set by Rob Jonker in place of a 1" round iron he found which checked L.C.R.C. #1370.

L.C.R.C. #1905	L.C.R.C. #5811
Remon. tag on NW side 5" Hickory S57°W 33.44'	Nail & remon tag in NE side 12" Ash S 32°E 33.10' (m. 33.14')
Remon. tag on SW side 10" Tr. Ash N65°W 60.08'	Nail & remon tag in W side 14" Oak S 01°E 32.77' (m. 32.74')
Remon. tag on W side 10" Oak S01°W 20.89'	Nail & remon tag in W side 8" Oak clump N 28°E 24.63' (m. 24.71')
Remon. tag on NE side 8" Ash S35°E 33.11'	Nail & remon tag in S side 12" tr. Ash N 65°W 60.18' (m. 60.08')

The selected location is accepted by me and is generally accepted by professional surveyors as the best available evidence of the position of the original corner.

- C. Description of monument for corner and accessories established to perpetuate locating the position of the corner:
- B-3 Standard Kent County Monument

- Nail & K.C. remon. tag on NE side 12" Ash S 32° E 33.14'
- Nail & K.C. remon. tag on W side 14" Oak S 01° E 32.74'
- Nail & K.C. remon. tag on W side 8" Oak clump N 28° E 24.71'
- Nail & K.C. remon. tag on S side 12" Triple Ash N 65° W 60.08'
- Nail & K.C. remon. tag on W side 10" Oak (stump) S 01° E 20.88'
- On C/L gravel road running E-W
- Fence line running S, West 5.0'

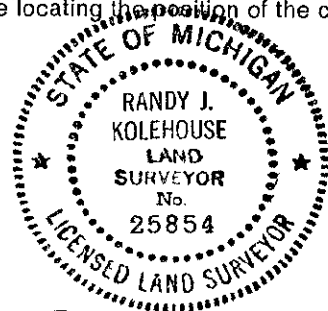

Signed by Randy J. Kolehouse
EARTH TECH

Date 9-1-98

Surveyor's Michigan License No. 25854