

SURVEY & REMONUMENTATION SURVEY & REMONUMENTATION
 \$7.00
 \$2.00
 MAR 08 1999

LAND CORNER RECORDATION CERTIFICATE
 Filing Requirement of Act 74, Mich. P.A. 1970
 KENT COUNTY REMONUMENTATION

For corners in SECTION
 Kent (County) Located in: Vergennes Township Corner Code #

1. Public Land Survey	T <u>7N</u>	R <u>9W</u>	<u>B-4</u>
	T _____	R _____	_____
	T _____	R _____	_____
	T _____	R _____	_____
2. Property Controlling in Section	S _____	T _____	R _____
	S _____	T _____	R _____
3. Miscellaneous Property in Sec.	S _____	T _____	R _____
	S _____	T _____	R _____

4. Lot No. _____, Recorded Plat _____
 5. Private Claims _____

STATE OF MICHIGAN
 COUNTY OF KENT
 RECEIVED FOR RECORD
 98 DEC 14 AM 8:00
 REG. OF DEEDS
Lucy Bond

11017
 Register of Deeds Stamp & File Number

I, Randy Kolehouse, in a field survey on November 30 19 98, do hereby certify that under requirements of P.A. 74 Michigan P.A. of 1970, the corner points mentioned in lines 1 and 2 above were in conformance with regulations and rules therefore as required in the current manual of survey instructions of the United States Department of the interior, Bureau of Land Management or by a decree of a Court of Law and/or that the corner points mentioned in lines 3, 4 and 5 above were in conformance with the rules of the Michigan Board of Land Surveyors or by a Decree of a Court of Law; established, re-established, monumented, re-monumented, recovered, found as expressed below:

NOTE: Not more than 4 corners, all in the same town and range, may be recorded on this certificate.

A. Description of original monument and accessories and/or subsequent restoration:
 B-4 This corner was not originally set by the G.L.O.
 No information on record for this corner.


	A	B	C	D	E	F	G	H	I	J	K	L	M
2	6		5		4		3		2		1		
3													
4	•		8		9		10		11		12		
5													
6	18		17		16		15		14		13		
7													
8	19		20		21		22		23		24		
9													
10	30		29		28		27		26		25		
11													
12	31		32		33		34		35		36		
13													

P.A. 345 1990 KENT COUNTY
 PEER APPROVED 9/24/98
 CHAIRMAN *Henry Huber*

B. Description of corner evidence found and/or method applied in restoring or reestablishing corner:
 B-4 Set a monument at the intersection of 1/4 lines in a field 2' ± below ground surface. Monument is 500' ± Northwest of the Southeast corner of a fence row running South and 100' ± West of a 2-track running North and South.

The selected location is accepted by me and is generally accepted by professional surveyors as the best available evidence of the position of the original corner.

C. Description of monument for corner and accessories established to perpetuate locating the position of the corner:
 B-4 Set a Standard Kent County Monument
 Nail & K.C. remon. tag on W side 16" Maple 6.5' above ground n 10° W 499.65'
 Nail & K.C. remon. tag on W side 14" Maple 5' above ground N 22° W 486.86'
 Nail & K.C. remon. tag on N side 70" Maple 5' above ground N 36° W 419.51'
 Nail & K.C. remon. tag on E side 12" Twin Cherry 5' above ground S 08° E 488.93'
 Southeast corner of fence row running S, Southeast 500'
 2-track running N-S, East 100'

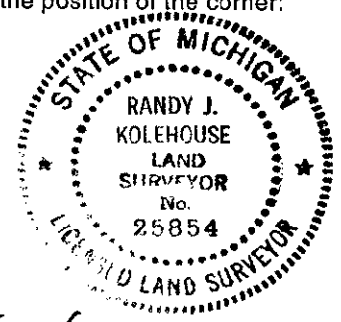

Signed by *Randy J. Kolehouse* Date 12/4/98
 EARTH TECH
 Surveyor's Michigan License No. 25854