

SURVEY & REMONUMENTATION

MAR 08 1999

LAND CORNER RECORDATION CERTIFICATE
Filing Requirement of Act 74, Mich. P.A. 1970
KENT COUNTY REMONUMENTATION

For corners in


Kent (County)	SECTION	Located in: Township	Vergennes	Corner Code #
1. Public Land Survey	T <u>7N</u>	R <u>9W</u>	<u>B-5</u>	
	T _____	R _____	_____	
	T _____	R _____	_____	
	T _____	R _____	_____	
2. Property Controlling in Section	S _____	T _____	R _____	
	S _____	T _____	R _____	
3. Miscellaneous Property in Sec.	S _____	T _____	R _____	
	S _____	T _____	R _____	

4. Lot No. _____, Recorded Plat _____
 5. Private Claims _____

STATE OF MICHIGAN
 COUNTY OF KENT
 RECEIVED FOR RECORD
 30 OCT 23 AM 9:55
 REG. OF DEEDS
W. J. ...

10732
 Register of Deeds Stamp & File Number

I, Randy Kolehouse, in a field survey on December 26 19 97, do hereby certify that under requirements of P.A. 74 Michigan P.A. of 1970, the corner points mentioned in lines 1 and 2 above were in conformance with regulations and rules therefore as required in the current manual of survey instructions of the United States Department of the interior, Bureau of Land Management or by a decree of a Court of Law and/or that the corner points mentioned in lines 3, 4 and 5 above were in conformance with the rules of the Michigan Board of Land Surveyors or by a Decree of a Court of Law; established, re-established, monumented, re-monumented, recovered, found as expressed below:

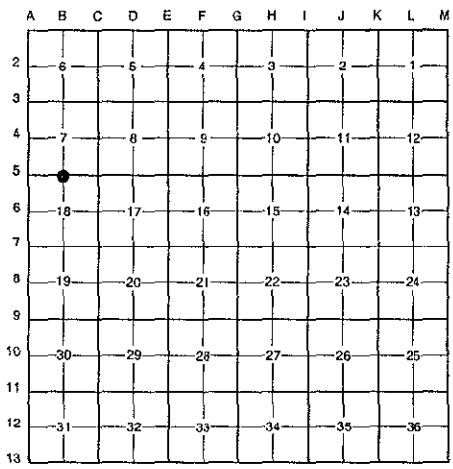

NOTE: Not more than 4 corners, all in the same town and range, may be recorded on this certificate.

A. Description of original monument and accessories and/or subsequent restoration:

B-5	1838	G.L.O. Notes	N. Brookfield	Set Post
	1966	Witness Map	K.C. Surveyor	Boat Spike
	1983	L.C.R.C. #3446	G. Fauser	3/4" Pipe
	1984	L.C.R.C. #3834	R. Kolehouse	Fnd. "T" Iron Over Stone / Set K.C. Monument
	1991	L.C.R.C. #5812	Exxel Engineering	K.C. Monument

P.A. 345 1990 KENT COUNTY
 PEER APPROVED 2/19/98
 CHAIRMAN *[Signature]*

This corner was originally approved by the Kent County Remonumentation Peer Group and monumented by Randy Kolehouse on 4/28/84 and was recorded per L.C.R.C. #3834.

B. Description of corner evidence found and/or method applied in restoring or reestablishing corner:

B-5 Found a Standard Kent County Monument on the C/L intersection of 2 Mile Road (bit.) running East and West and 32' West of the C/L of Bergin Avenue (gravel) running North, on line of a tree row running South, per L.C.R.C.'s #3834 and #5812 as set by Randy Kolehouse in place of a "T" iron he found over a 3/4" iron over a stone 26" below grade which checked L.C.R.C. #3446 and the K.C. Surveyor's records.

L.C.R.C. #3834

L.C.R.C. #5812


Nail & K.C. Remon. tag in SW side 6" Oak S 45 E 53.95'
 Nail & K.C. Remon. tag in N. side 14" Hickory S 55 W 59.69'
 Nail & K.C. Remon. tag in W. side 14" Oak South 54.65'
 Nail & K.C. Remon. tag in E. side Tw. 14" Oak North 72.70'

Nail & KC remon tag in SW side 14" quad(4) Oaks S 42°E 53.88' (m. 53.84')
 Nail & KC remon tag in N side 14" Hickory S 59°W 59.65' (m. 59.61')
 Nail & KC remon tag in W side 14" Oak S 0°W 54.48' (m. 54.45')
 Nail & KC remon tag in E side Tw. 14" Oak N 5°E 72.74' (m. 72.80')
 Nail & KC remon tag in S side 12" Elm N 71°E 88.14'

The selected location is accepted by me and is generally accepted by professional surveyors as the best available evidence of the position of the original corner.

C. Description of monument for corner and accessories established to perpetuate locating the position of the corner:

B-5 Standard Kent County Monument
 Nail & K.C. remon. tag on SW side 14" quad. (4) Oaks S 42° E 53.84'
 Nail & K.C. remon. tag on N side 14" Hickory S 59° W 59.61'
 Nail & K.C. remon. tag on W side 14" Oak S 00° W 54.45'
 Nail & K.C. remon. tag on E side 14" Twin Oak N 05° E 72.80'
 Nail & K.C. remon. tag on S side 12" Elm N 71° E 88.14'
 C/L "X" bit. road running E-W and gravel road running N, East 32.0'
 On tree row running S

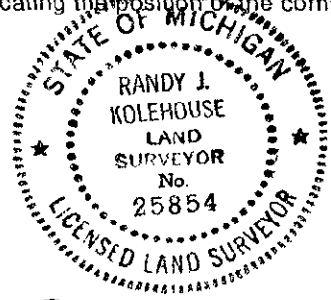

Signed by *Randy J. Kolehouse* Date 9-1-98
 EARTH TECH

Surveyor's Michigan License No. 25854