

**SURVEY & REMONUMENTATION**

\$7.00  
\$2.00

MAR 08 1999

**LAND CORNER RECORDATION CERTIFICATE**  
Filing Requirement of Act 74, Mich. P.A. 1970  
KENT COUNTY REMONUMENTATION

For corners in SECTION

Kent (County)	Located in: Vergennes Township	Corner Code #
1. Public Land Survey	T <u>7N</u> R <u>9W</u>	<u>B-6</u>
	T _____ R _____	_____
	T _____ R _____	_____
	T _____ R _____	_____
2. Property Controlling in Section	S _____ T _____ R _____	_____
	S _____ T _____ R _____	_____
3. Miscellaneous Property in Sec.	S _____ T _____ R _____	_____
	S _____ T _____ R _____	_____
4. Lot No. _____, Recorded Plat _____		
5. Private Claims _____		

STATE OF MICHIGAN  
COUNTY OF KENT  
RECEIVED FOR RECORD  
98 DEC 14 AM 8:00  
REG. OF DEEDS  
*Lucy Spauld*


**10934**  
Register of Deeds Stamp & File Number

I, Randy Kolehouse, in a field survey on December 30 19 97, do hereby certify that under requirements of P.A. 74 Michigan P.A. of 1970, the corner points mentioned in lines 1 and 2 above were in conformance with regulations and rules therefore as required in the current manual of survey instructions of the United States Department of the Interior, Bureau of Land Management or by a decree of a Court of Law and/or that the corner points mentioned in lines 3, 4 and 5 above were in conformance with the rules of the Michigan Board of Land Surveyors or by a Decree of a Court of Law; established, re-established, monumented, re-monumented, recovered, found as expressed below:

**NOTE: Not more than 4 corners, all in the same town and range, may be recorded on this certificate.**

A. Description of original monument and accessories and/or subsequent restoration:

B-6	This corner was not originally set by the G.L.O.		
1964	Witness Map	K.C. Surveyor	1/2" Iron
1972	L.C.R.C. #280	Medema, Van Kooten & Assoc.	C.P. Capped Iron
1978	Cert. Survey L. 82 P. 35	Nederveld & Jonker	Cap on Rerod
1978	Cert. Survey L. 83 P. 33	Nederveld & Jonker	Cap on Rerod
1988	Cert. Survey L. 202 P. 19	Exxel Engineering	Capped Re-rod
1978	L.C.R.C. #4056	Nederveld Associates	Capped Rerod
N/A	Records	Consumers Power Co.	Boat Spike

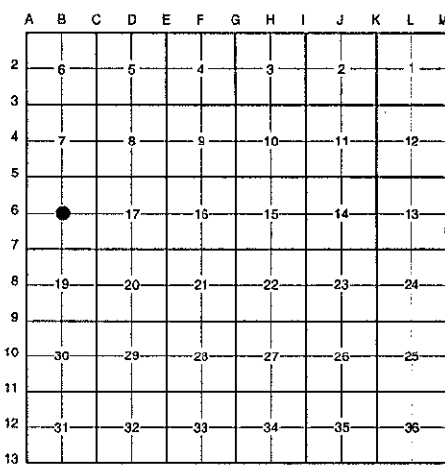

B. Description of corner evidence found and/or method applied in restoring or reestablishing corner:


B-6 Found a 1/2" iron on the C/L of Downes Road (gravel) running East and West, on a tree row running North, per L.C.R.C.'s #280 and #4056 and Cert. Surveys L. 82 P. 35, L. 83 P. 33, and L. 202 P. 19. Iron is 0.3' North and 0.6' East of the intersection of 1/4 lines. Consumers Power Company records indicated iron set at the intersection of 1/4 lines. Accepted iron as Center of Section.

L.C.R.C. #280	L.C.R.C. #4056
Nail in side 30" Oak NNW 28.83'	Nail in 26" Oak SW 51.04' (m. 50.99')
Nail in side 20" Oak WSW 51.71'	Nail in 12" W. Cherry S-SW 34.75' (m. 34.80')
Nail in side Dble W Cherry 34.75'	Nail in 42" Oak N-NW 28.8' (m. 28.68')
(Spike) Nail in side tw. 10" Oak ENE 60.30'	Nail in 12" Oak E-NE 60.4' (m. 61.21')

The selected location is accepted by me and is generally accepted by professional surveyors as the best available evidence of the position of the original corner.

C. Description of monument for corner and accessories established to perpetuate locating the position of the corner:

- B-6 Replaced Iron with a Standard Kent County Monument
- Nail & K.C. remon. tag on NW side 30" Oak (partial dead) S 63° W 50.99'
  - Nail & K.C. remon. tag on W side 18" W. Cherry S 15° W 34.80'
  - Nail & K.C. remon. tag on E side 42" Oak N 05° W 28.68'
  - Nail & K.C. remon. tag on S side 8" Oak N 75° E 61.21'
  - Nail & K.C. remon. tag on NE side 12" Hickory S 20° E 35.66'
  - C/L of gravel road running E-W
  - On tree row running N

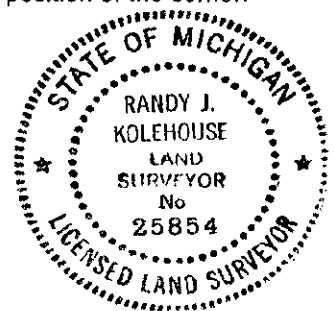

Signed by *Randy J. Kolehouse* Date 11/18/98

Surveyor's Michigan License No. 25854