

**SURVEY & REMONUMENTATION**

\$7.00  
\$2.00

MAR 08 1999

**LAND CORNER RECORDATION CERTIFICATE**  
Filing Requirement of Act 74, Mich. P.A. 1970  
KENT COUNTY REMONUMENTATION

STATE OF MICHIGAN  
COUNTY OF KENT  
RECEIVED FOR RECORD  
38 OCT 23 AM 9:55  
REG. OF DEEDS  
*Luis J. Kulehouse*

**SECTION**


For corners in

Kent (County)	Located in: Vergennes Township	Corner Code #
1. Public Land Survey	T <u>7N</u> R <u>9W</u>	<u>B-7</u>
	T _____ R _____	_____
	T _____ R _____	_____
	T _____ R _____	_____
2. Property Controlling in Section	S _____ T _____ R _____	_____
	S _____ T _____ R _____	_____
3. Miscellaneous Property in Sec.	S _____ T _____ R _____	_____
	S _____ T _____ R _____	_____

**10733**

Register of Deeds Stamp & File Number

- 4. Lot No. \_\_\_\_\_, Recorded Plat \_\_\_\_\_
- 5. Private Claims \_\_\_\_\_

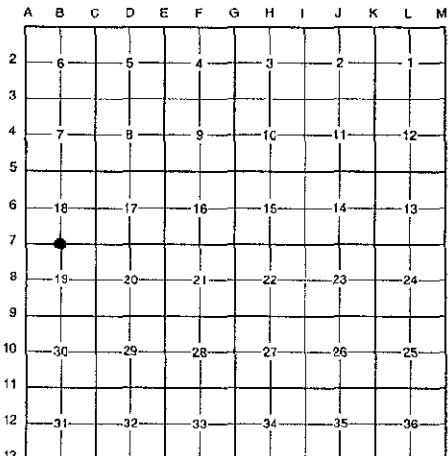

I, Randy Kolehouse, in a field survey on January 7, 19 98, do hereby certify that under requirements of P.A. 74 Michigan P.A. of 1970, the corner points mentioned in lines 1 and 2 above were in conformance with regulations and rules therefore as required in the current manual of survey instructions of the United States Department of the interior, Bureau of Land Management or by a decree of a Court of Law and/or that the corner points mentioned in lines 3, 4 and 5 above were in conformance with the rules of the Michigan Board of Land Surveyors or by a Decree of a Court of Law; established, re-established, monumented, re-monumented, recovered, found as expressed below:

**NOTE: Not more than 4 corners, all in the same town and range, may be recorded on this certificate.**

A. Description of original monument and accessories and/or subsequent restoration:

B-7	1838	G.L.O. Notes	N. Brookfield	Set Post
	N/A	Witness Map	K.C. Surveyor	"T" Iron
	1972	L.C.R.C. #280	Medema, Van Kooten & Assoc.	"T" Iron
	1981	L.C.R.C. #1906	Jonker Land Survey	Fnd. "T" Iron / Set K.C. Monument
	1991	L.C.R.C. #5813	R. Unema	K.C. Monument

P.A. 345 1990 KENT COUNTY  
PEER APPROVED 2/19/98  
CHAIRMAN [Signature]

This corner was originally approved by the Kent County Remonumentation Peer Group and monumented by Rob Jonker on 7/14/81 and was recorded per L.C.R.C. #1906.

B. Description of corner evidence found and/or method applied in restoring or reestablishing corner:

B-7 Found a Standard Kent County Monument on line of a downed fence line running East, West, and South per L.C.R.C.'s #1906 and #5813 as set by Rob Jonker in place of a "T" iron he found which checked L.C.R.C. #280 and the K.C. Surveyor's records.

**L.C.R.C. #1906**

**L.C.R.C. #5813**

- Remon. tag on S side 8" Maple N 58° E 6.72'
- Remon. tag on SE side 10" Oak N 33° E 27.89'
- Remon. tag on S side 10" Maple N 63° W 31.18'
- Remon. tag on N side 9" Hickory S 84° W 26.09'
- Remon. tag on E side 12" Ash S 20° W 28.37'

- Remon. tag on S side 10" Maple N 63° E 6.70' (m. 6.69')
- Remon. tag on N side 10" Hickory S 85° W 26.12' (m. 26.07')
- Remon. tag on SE side 12" Oak N 36° E 27.96' (m. 27.98')
- Remon. tag on S side 10" Maple N 64° W 31.16' (m. 31.14')
- Remon. tag on E side 14" Ash S 20° W 28.34' (m. 28.29')

The selected location is accepted by me and is generally accepted by professional surveyors as the best available evidence of the position of the original corner.

C. Description of monument for corner and accessories established to perpetuate locating the position of the corner:

- B-7 Standard Kent County Monument
- Nail & K.C. remon. tag on S side 10" Maple N 63° E 6.69'
  - Nail & K.C. remon. tag on N side 10" Hickory S 85° W 26.07'
  - Nail & K.C. remon. tag on SE side 12" Oak N 36° E 27.98'
  - Nail & K.C. remon. tag on S side 10" Maple N 64° W 31.14'
  - Nail & K.C. remon. tag on E side 14" Ash S 20° W 28.29'
  - NW edge large stone S 10° E 1.6'
  - At intersection of downed fence line running E, W & S



Signed by Randy J. Kolehouse Date 9-1-98  
EARTH TECH  
Surveyor's Michigan License No. 25854