

\$7.00
\$2.00

SURVEY &
REMONUMENTATION

MAR 08 1999

LAND CORNER RECORDATION CERTIFICATE
Filing Requirement of Act 74, Mich. P.A. 1970
KENT COUNTY REMONUMENTATION

For corners in

Kent (County)	SECTION	Located in: Vergennes Township	Corner Code #
1. Public Land Survey	T <u>7N</u> R <u>9W</u>		<u>B-8</u>
	T _____ R _____		_____
	T _____ R _____		_____
	T _____ R _____		_____
2. Property Controlling in Section	S _____ T _____ R _____		_____
	S _____ T _____ R _____		_____
3. Miscellaneous Property in Sec.	S _____ T _____ R _____		_____
	S _____ T _____ R _____		_____

REG. OF DEEDS

Randy Kohhouse

98 DEC 14 AM 8:00

STATE OF MICHIGAN
COUNTY OF KENT
RECEIVED FOR RECORD

11018

Register of Deeds Stamp & File Number


- 4. Lot No. _____, Recorded Plat _____
- 5. Private Claims _____

I, Randy Kohhouse, in a field survey on October 30 19 98, do hereby certify that under requirements of P.A. 74 Michigan P.A. of 1970, the corner points mentioned in lines 1 and 2 above were in conformance with regulations and rules therefore as required in the current manual of survey instructions of the United States Department of the interior, Bureau of Land Management or by a decree of a Court of Law and/or that the corner points mentioned in lines 3, 4 and 5 above were in conformance with the rules of the Michigan Board of Land Surveyors or by a Decree of a Court of Law; established, re-established, monumented, re-monumented, recovered, found as expressed below:

NOTE: Not more than 4 corners, all in the same town and range, may be recorded on this certificate.

A. Description of original monument and accessories and/or subsequent restoration:

B-8 This corner was not originally set by the G.L.O.
No information on record for this corner.

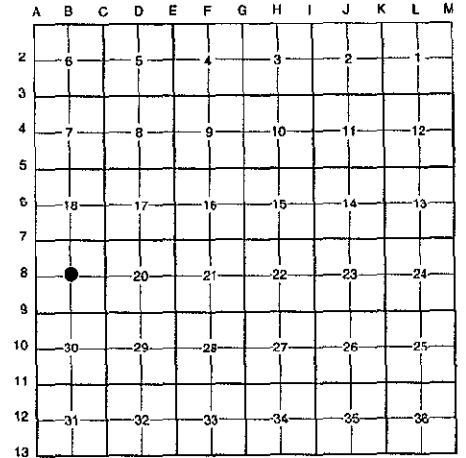

P.A. 346 1970 KENT COUNTY

PEER APPROVED 11/12/98

CHAIRMAN *Randy Kohhouse*

B. Description of corner evidence found and/or method applied in restoring or reestablishing corner:


B-8. Set a monument at the intersection of 1/4 lines. Monument is in the middle of a field, 500' ± East of line of woods running West and South, and 800' ± North of Southerly line of woods running East.

The selected location is accepted by me and is generally accepted by professional surveyors as the best available evidence of the position of the original corner.

C. Description of monument for corner and accessories established to perpetuate locating the position of the corner:

B-8 Set a Standard Kent County Monument

- Nail & K.C. remon. tag on N side 14" Oak N 65° W 96.27'
- Nail & K.C. remon. tag on W side 4" Sumac South 229.44'
- Top bolt on NE leg to high power tower bolt on E side leg S 25° W 228.44'
- Top bolt on SE leg to high power tower bolt on E side leg North 101.86'
- Line of woods running W and S, West 500'
- Line of woods running East, South 800'

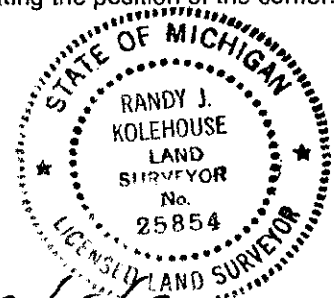

Signed by *Randy J. Kohhouse*

Date 12/4/98

Surveyor's Michigan License No. 25854