

\$7.00 SURVEY & REMONUMENTATION
\$2.00
 MAR 08 1999

STATE OF MICHIGAN
 COUNTY OF KENT
 RECEIVED FOR RECORDS
 99 OCT 23 AM 9:55
 REG. OF DEEDS
W. J. Board

LAND CORNER RECORDATION CERTIFICATE
 Filing Requirement of Act 74, Mich. P.A. 1970
 KENT COUNTY REMONUMENTATION


For corners in **SECTION**

Kent (County)	Located in: Vergennes Township	Corner Code #
1. Public Land Survey	T <u>7N</u> R <u>9W</u>	<u>B-9</u>
	T _____ R _____	_____
	T _____ R _____	_____
	T _____ R _____	_____
2. Property Controlling in Section	S _____ T _____ R _____	_____
	S _____ T _____ R _____	_____
3. Miscellaneous Property in Sec.	S _____ T _____ R _____	_____
	S _____ T _____ R _____	_____
4. Lot No. _____, Recorded Plat _____		
5. Private Claims _____		

10734
 Register of Deeds Stamp & File Number

I, Randy Kolehouse, in a field survey on December 31 19 97, do hereby certify that under requirements of P.A. 74 Michigan P.A. of 1970, the corner points mentioned in lines 1 and 2 above were in conformance with regulations and rules therefore as required in the current manual of survey instructions of the United States Department of the interior, Bureau of Land Management or by a decree of a Court of Law and/or that the corner points mentioned in lines 3, 4 and 5 above were in conformance with the rules of the Michigan Board of Land Surveyors or by a Decree of a Court of Law; established, re-established, monumented, re-monumented, recovered, found as expressed below:

NOTE: Not more than 4 corners, all in the same town and range, may be recorded on this certificate.

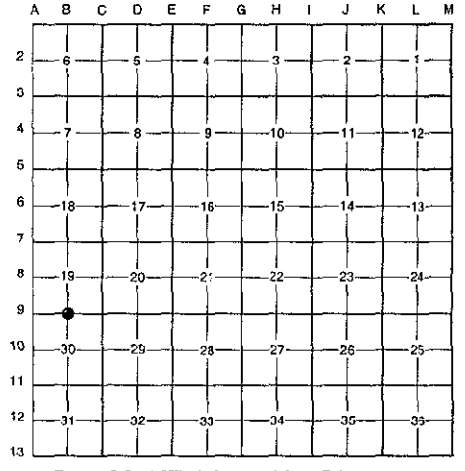

A. Description of original monument and accessories and/or subsequent restoration:

B-9	1838	G.L.O. Notes	N. Brookfield	Set Post
	1958	Witness Map	K.C. Surveyor	1" Iron
	1977	L.C.R.C. #984	J. McCloskey	Iron
	1981	L.C.R.C. #1924	Jonker Land Survey	Fnd. 1/2" Round Iron / Set K.C. Monument
	1991	L.C.R.C. #5814	R. Unema	K.C. Monument

P.A. 345 1990 KENT COUNTY
 PEER APPROVED 2/19/98
 CHAIRMAN *Harry Huber*

This corner was originally approved by the Kent County Remonumentation Peer Group and monumented by Rob Jonker on 7/9/81 and was recorded per L.C.R.C. #1924.

B. Description of corner evidence found and/or method applied in restoring or reestablishing corner:

B-9 Found a Standard Kent County Monument 1' North of the C/L of Bailey Road (bit.) running East and West, on line of a tree row running South, per L.C.R.C.'s #1924 and #5814 as set by Rob Jonker in place of a 1/2" round iron he found at grade inside of a 1-1/2" x 30" round pipe 6" below grade which checked L.C.R.C. #984 and the K.C. Surveyor's records.


L.C.R.C. #1924	L.C.R.C. #5814
Remon. tag on SW side 38" Oak N 56° W 59.09'	Nail & remon tag on SW side 40" Oak N 59° W 59.54' (m. 59.56')
NW Cor. fnd. to conc. block bldg. S 44° E 90.75'	NW cor fnd to conc. blk. bldg S 42° E 90.76' (m. 90.80')
SE Cor. base conc. porch N 16° E 100.63'	SE cor base conc porch N 16° E 100.64' (m. 100.66')
	Nail & remon tag on E side tw. 10" Elm S 1° W 53.20' (m. 53.23')
	Nail & remon tag on S side 44" Oak N 81° E 114.04' (m. 114.05')

The selected location is accepted by me and is generally accepted by professional surveyors as the best available evidence of the position of the original corner.

C. Description of monument for corner and accessories established to perpetuate locating the position of the corner:

B-9 Standard Kent County Monument

Nail & K.C. remon. tag on SW side 40" Oak N 59° W 59.56'
 NW cor. fndn. to conc. blk. bldg. S 42° E 90.80'
 SE cor. base conc. porch N 16° E 100.66'
 Nail & K.C. remon. tag on E side Twin 10" Elm S 01° W 53.23'
 Nail & K.C. remon. tag on S side 44" Oak N 81° E 114.05'
 C/L bit. road running E-W, South 1.0'
 On tree row running S

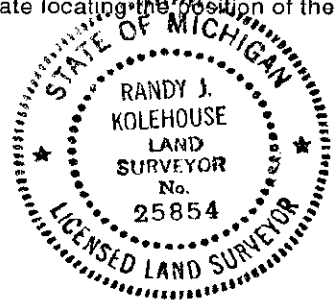

Signed by Randy J. Kolehouse Date 9-1-98
 EARTH TECH
 Surveyor's Michigan License No. 25854