

SURVEY & REMONUMENTATION

\$7.00
\$2.00

MAR 08 1999

LAND CORNER RECORDATION CERTIFICATE
Filing Requirement of Act 74, Mich. P.A. 1970
KENT COUNTY REMONUMENTATION

For corners in SECTION

Kent (County)	Located in:	Vergennes Township	Corner Code #
1. Public Land Survey	T <u>7N</u>	R <u>9W</u>	<u>B-10</u>
	T _____	R _____	_____
	T _____	R _____	_____
	T _____	R _____	_____
2. Property Controlling in Section	S _____	T _____	R _____
	S _____	T _____	R _____
3. Miscellaneous Property in Sec.	S _____	T _____	R _____
	S _____	T _____	R _____

STATE OF MICHIGAN
COUNTY OF KENT
RECEIVED FOR RECORD
98 DEC 14 AM 8:00
REG. OF DEEDS
David Storch

11019

Register of Deeds Stamp & File Number

4. Lot No. _____, Recorded Plat _____
5. Private Claims _____

I, Randy Kolehouse, in a field survey on December 2 19 98, do hereby certify that under requirements of P.A. 74 Michigan P.A. of 1970, the corner points mentioned in lines 1 and 2 above were in conformance with regulations and rules therefore as required in the current manual of survey instructions of the United States Department of the interior, Bureau of Land Management or by a decree of a Court of Law and/or that the corner points mentioned in lines 3, 4 and 5 above were in conformance with the rules of the Michigan Board of Land Surveyors or by a Decree of a Court of Law; established, re-established, monumented, re-monumented, recovered, found as expressed below:

	A	B	C	D	E	F	G	H	I	J	K	L	M
2	6	5	4	3	2	1							
3													
4	7	8	9	10	11	12							
5													
6	18	17	16	15	14	13							
7													
8	19	20	21	22	23	24							
9													
10	●	29	28	27	26	25							
11													
12	31	32	33	34	35	36							
13													

NOTE: Not more than 4 corners, all in the same town and range, may be recorded on this certificate.

A. Description of original monument and accessories and/or subsequent restoration:

B-10 This corner was not originally set by the G.L.O.

1976± Survey Consumers Power Co. Held Intersection of 1/4 Lines / No Corner Set

P.A. 345 1990 KENT COUNTY
PEER APPROVED 8/20/98
CHAIRMAN Randy Kolehouse

B. Description of corner evidence found and/or method applied in restoring or reestablishing corner:


B-10 Set a monument at the intersection of 1/4 lines. Monument is on line of a tree row running North and South, 100' ± North of a tree row running West, 15' ± East of a 2-track running North and South. This point checks measurements in Consumers Power Survey 0.1' ±.

The selected location is accepted by me and is generally accepted by professional surveyors as the best available evidence of the position of the original corner.

C. Description of monument for corner and accessories established to perpetuate locating the position of the corner:

B-10 Set a Standard Kent County Monument

- Nail & K.C. remon. tag on W side 6" Elm N 30° E 21.47'
- Nail & K.C. remon. tag on SE'ly side 8" Maple N 45° E 23.75'
- Nail & K.C. remon. tag on SW'ly side 14" Maple S 63° E 2.96'
- Nail & K.C. remon. tag on W side 6" Maple S 06° E 15.15'
- On tree row running N-S
- Tree row running W, South 100'
- 2-track running N-S, West 15'

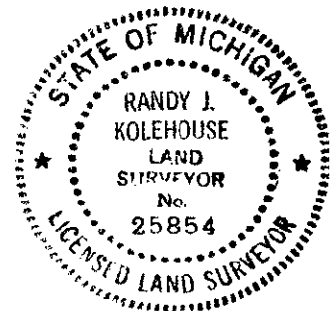

Signed by Randy J. Kolehouse Date 12/4/98
EARTH TECH
Surveyor's Michigan License No. 25854