

SURVEY & REMONUMENTATION

MAR 08 1999

\$7.00
\$2.00

SECTION

LAND CORNER RECORDATION CERTIFICATE
Filing Requirement of Act 74, Mich. P.A. 1970
KENT COUNTY REMONUMENTATION

For corners in

Kent (County)	Located in: Vergennes Township	Corner Code #
1. Public Land Survey	T <u>7N</u> R <u>9W</u>	<u>B-11</u>
	T _____ R _____	_____
	T _____ R _____	_____
	T _____ R _____	_____
2. Property Controlling in Section	S _____ T _____ R _____	_____
	S _____ T _____ R _____	_____
3. Miscellaneous Property in Sec.	S _____ T _____ R _____	_____
	S _____ T _____ R _____	_____

STATE OF MICHIGAN
COUNTY OF KENT
RECEIVED FOR RECORD

98 OCT 23 AM 9:55

REG. OF DEEDS
W. J. Sand

10735

Register of Deeds Stamp & File Number


4. Lot No. _____, Recorded Plat _____
5. Private Claims _____

I, Randy Kolehouse, in a field survey on January 5 19 98, do hereby certify that under requirements of P.A. 74 Michigan P.A. of 1970, the corner points mentioned in lines 1 and 2 above were in conformance with regulations and rules therefore as required in the current manual of survey instructions of the United States Department of the interior, Bureau of Land Management or by a decree of a Court of Law and/or that the corner points mentioned in lines 3, 4 and 5 above were in conformance with the rules of the Michigan Board of Land Surveyors or by a Decree of a Court of Law; established, re-established, monumented, re-monumented, recovered, found as expressed below:

NOTE: Not more than 4 corners, all in the same town and range, may be recorded on this certificate.

A. Description of original monument and accessories and/or subsequent restoration:

B-11	1838	G.L.O. Notes	N. Brookfield	Set Post
	N/A	Witness Map	K.C. Surveyor	1" iron
	1975	L.C.R.C. #918	E. McCombs	"T" Iron
	1981	L.C.R.C. #1925	Jonker Land Survey	Fnd. "T" Iron / Set K.C. Monument
	1991	L.C.R.C. #5815	Exxel Engineering	K.C. Monument

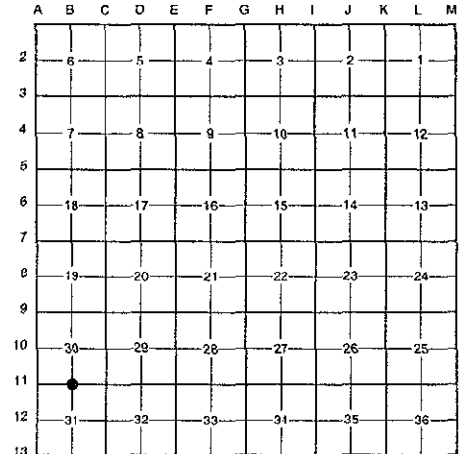

P.A. 345 1990 KENT COUNTY
PEER APPROVED 2/12/99
CHAIRMAN Randy Kolehouse

This corner was originally approved by the Kent County Remonumentation Peer Group and monumented by Rob Jonker on 7/9/81 and was recorded per L.C.R.C. #1925.

B. Description of corner evidence found and/or method applied in restoring or reestablishing corner:

B-11 Found a Standard Kent County Monument on the C/L of Vergennes Street (bit.) running East and West, on line of a fence line running South, per L.C.R.C.'s #1925 and #5815 as set by Rob Jonker in place of a "T" iron he found which checked L.C.R.C. #918 and the K.C. Surveyor's records.

L.C.R.C. #1925

- Remon. tag on W side 32" Oak S30°W 32.23'
- Remon. tag on NW side 36" Oak S61°W 54.52'
- Remon. tag on W side P.pole N01°E 58.68'

L.C.R.C. #5815


- Nail & remon tag in W side 36" Oak S 33°W 31.10' (31.07')
- Nail & remon tag in NW side 40" Oak S 63°W 54.28' (m. 54.16')
- Nail & remon tag in SW side 8" Oak S 66°E 86.08' (m. 86.03')
- Nail & remon tag in S side 10" Hickory N 78°E 93.75' (m. 93.73')

The selected location is accepted by me and is generally accepted by professional surveyors as the best available evidence of the position of the original corner.

C. Description of monument for corner and accessories established to perpetuate locating the position of the corner:

B-11 Standard Kent County Monument

- Nail & K.C. remon. tag on W side 36" Oak S 33° W 31.07'
- Nail & K.C. remon. tag on NW side 40" Oak S 63° W 54.16'
- Nail & K.C. remon. tag on SW side 8" Oak S 66° E 86.03'
- Nail & K.C. remon. tag on S side 10" Hickory N 78° E 93.73'
- Nail & K.C. remon. tag on W side P. pole North 58.74'
- On C/L bit. road running E-W
- On fence line running S

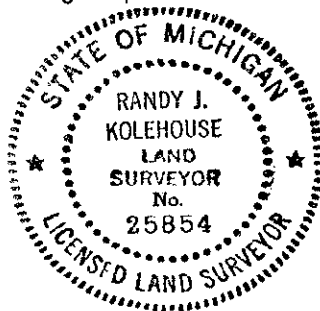

Signed by Randy J. Kolehouse Date 9-1-98
EARTH TECH

Surveyor's Michigan License No. 25854