

SURVEY & REMONUMENTATION

MAY 22 2000

Seg 2

SECTION

LAND CORNER RECORDATION CERTIFICATE
 Filing Requirement of Act 74, Mich. P.A. 1970
 KENT COUNTY REMONUMENTATION

For corners in

Kent (County)	Located in: Vergennes Township	Corner Code #
1. Public Land Survey	T <u>7N</u> R <u>9W</u>	<u>B-12</u>
	T _____ R _____	_____
	T _____ R _____	_____
	T _____ R _____	_____
2. Property Controlling in Section	S _____ T _____ R _____	_____
	S _____ T _____ R _____	_____
3. Miscellaneous Property in Sec.	S _____ T _____ R _____	_____
	S _____ T _____ R _____	_____

REG. OF DEEDS

[Signature]

STATE OF MICHIGAN
 COUNTY OF KENT
 RECEIVED FOR RECORD
 1999 DEC 30 AM 9:54

11693

Register of Deeds Stamp & File Number

4. Lot No. _____, Recorded Plat _____
 5. Private Claims _____

I, Randy Kolehouse, in a field survey on December 29 19 99, do hereby certify that under requirements of P.A. 74 Michigan P.A. of 1970, the corner points mentioned in lines 1 and 2 above were in conformance with regulations and rules therefore as required in the current manual of survey instructions of the United States Department of the Interior, Bureau of Land Management or by a decree of a Court of Law and/or that the corner points mentioned in lines 3, 4 and 5 above were in conformance with the rules of the Michigan Board of Land Surveyors or by a Decree of a Court of Law; established, re-established, monumented, re-monumented, recovered, found as expressed below:

	A	B	C	D	E	F	G	H	I	J	K	L	M
2	6	5	4	3	2	1							
3													
4	7	8	9	10	11	12							
5													
6	16	17	16	15	14	13							
7													
8	19	20	21	22	23	24							
9													
10	30	29	28	27	26	25							
11													
12	●	32	33	34	35	36							
13													

NOTE: Not more than 4 corners, all in the same town and range, may be recorded on this certificate.

A. Description of original monument and accessories and/or subsequent restoration:

B-12 This corner was not originally set by the G.L.O.

1970	Witness Map	K.C. Surveyor	"T" Iron
1981	Cert. Survey L. 113 P. 43	Medema, Van Kooten & Assoc.	"T" Iron
1985	L.C.R.C. #4166	Exxel Engineering	"T" Iron
1998	L.C.R.C. #10935	Earth Tech	Set K.C. Monument

This corner was originally approved by the Kent County Remonumentation Peer Group and monumented by Earth Tech on 1/6/98 and was recorded per L.C.R.C. #10935.

B. Description of corner evidence found and/or method applied in restoring or reestablishing corner:

B-12 Found a Standard Kent County Monument per L.C.R.C. #10935 witnesses as set by Earth Tech.

L.C.R.C. #10935

- Nail & K.C. remon. tag on NE side 12" Maple N 19° W 40.59'
- Nail & K.C. remon. tag on W side 22" Oak N 05° E 43.24'
- Nail & K.C. remon. tag on E side 20" Ash S 08° E 38.16'
- Nail & K.C. remon. tag on SE side 28" Maple S 47° W 59.10'
- C/L of bit. road running E-W, North .5'
- On tree row running South


P.A. 345 1990 KENT COUNTY
 PEER APPROVED 2/30/99
 CHAIRMAN [Signature]

The selected location is accepted by me and is generally accepted by professional surveyors as the best available evidence of the position of the original corner.

C. Description of monument for corner and accessories established to perpetuate locating the position of the corner:

B-12 Reset a Standard Kent County Monument - Also Set a Monument Box

- Nail & K.C. remon. tag on NE side 12" Maple N 19° W 40.59'
- Nail & K.C. remon. tag on W side 22" Oak N 05° E 43.24'
- Nail & K.C. remon. tag on E side 20" Ash S 08° E 38.16'
- Nail & K.C. remon. tag on SE side 28" Maple S 47° W 59.10'
- C/L of bit. road running E-W, North .5'
- On tree row running South

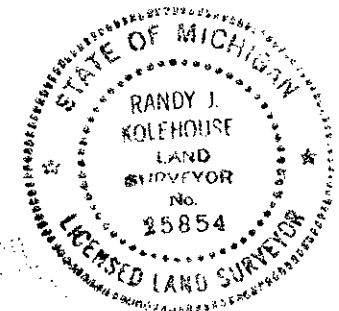

Signed by Randy J. Kolehouse Date 12-29-99
 WILLIAMS & WORKS
 Surveyor's Michigan License No. 25854