

SURVEY & REMONUMENTATION

MAR 03 1998

KENT COUNTY REMONUMENTATION

STATE OF MICHIGAN
COUNTY OF KENT
RECEIVED FOR RECORD

97 APR 29 AM 8:28

SECTION

LAND CORNER RECORDATION CERTIFICATE
Filing Requirement of Act 74, Mich. P.A. 1970

For corners in

KENT COUNTY

(County)

Located In:

Corner Code #

- | | | |
|------------------------------------|--|-------|
| 1. Public Land Survey | T <u>7</u> N R <u>9</u> W | B-13 |
| | T <u> </u> R <u> </u> | _____ |
| | T <u> </u> R <u> </u> | _____ |
| | T <u> </u> R <u> </u> | _____ |
| 2. Property Controlling in Section | S <u> </u> T <u> </u> R <u> </u> | _____ |
| | S <u> </u> T <u> </u> R <u> </u> | _____ |
| 3. Miscellaneous Property in Sec. | S <u> </u> T <u> </u> R <u> </u> | _____ |
| | S <u> </u> T <u> </u> R <u> </u> | _____ |

REG. OF DEEDS

9900

Register of Deeds Stamp & File Number

4. Lot No. _____, Recorded Plat _____
5. Private Claims _____

I, Kirk Breitels, in a field survey on Mar. 5, 1997 do hereby state that under requirements of P.A. 74, Michigan P.A. of 1970, the corner points mentioned in lines 1 and 2 above were in conformance with regulations and rules therefore as required in the current manual of survey instructions of the United States Department of the Interior, Bureau of Land Management or by a decree of a Court of Law and/or that the corner points mentioned in lines 3, 4 and 5 above were in conformance with the rules of the Michigan Board of Land Surveyors or by a Decree of a Court of Law, established, re-established, monumented, recovered, found as expressed below:

NOTE: Not more than 2 corners, all in the same town and range, may be recorded on this certificate.

1	A	B	C	D	E	F	G	H	I	J	K	L	M
2		6		5		4		3		2		1	
3													
4		7		8		9		10		11		12	
5													
6		18		17		16		15		14		13	
7													
8		19		20		21		22		23		24	
9													
10		30		29		28		27		26		25	
11													
12		31		32		33		34		35		36	
13													

A. Description of original monument and accessories and/or subsequent restoration:

B-13	1830	GLO	Mullett	Set Post
	1975	LCRC #917	McCombs	"T" Iron
	1981	LCRC #1766	Merdzinski	Set Kent County Monument
	1991	LCRC #5817	Unema	Kent County Monument

The position of this corner was previously approved by the Kent County Remonumentation Peer Group, monumented by John A. Merdzinski on 1/28/81 and was recorded per LCRC #1766

B. Description of corner evidence found and/or method applied in restoring or reestablishing corner:


B-13 Found standard Kent Co. Mon. (Harrison) per witnesses from above LCRC as set by John A. Merdzinski in place of the "T" Iron in a ring of stones. Said "T" Iron checks with LCRC #917.

<u>LCRC #1766</u>	Nail & tag 24" Oak	N40°W	48.50'	<u>LCRC #5817</u>	Nail & tag 26" Oak	N38°W	48.52'
	Nail & tag 4" Cherry	N00°E	30.88'		Nail & tag 16" Cherry	N03°E	34.20'
	Nail & tag 12" Oak	N70°E	52.53'		Nail & tag 16" Oak	N70°E	52.61'
	Nail & tag 12" Elm	S50°E	69.48'		Nail & tag 10" Oak	S46°W	49.18'
	Nail & tag 4" Oak	S50°W	49.20'		K.C. Mon. (B-1, 6-9)	West	89.12'
	Nail & tag 8" Hickory	S75°W	93.28'				
	Nail & tag 6" Hickory	N50°E	39.10'				

The selected location is accepted by me and is generally accepted by professional surveyors as the best available evidence of the position of the original corner.

C. Description of monument for corner and accessories established to perpetuate locating the position of the corner:

- B-13 Standard Kent County Monument
- | | | | |
|-------------------------------|------------|-------|--------|
| Nail & KC Remon. tag NE side | 28" Oak | N38°W | 48.52' |
| Nail & KC Remon. tag E. side | 22" Cherry | N03°W | 34.20' |
| Nail & KC Remon. tag SE side | 20" Oak | N70°E | 52.61' |
| Nail & KC Remon. tag E. side | 14" Oak | S46°W | 49.18' |
| Kent Co. Mon. (B-1, T6N, R9W) | | West | 89.12' |
- C/L grav. rd. is South 2'± and on fence line South
Top of monument is 3"± under road

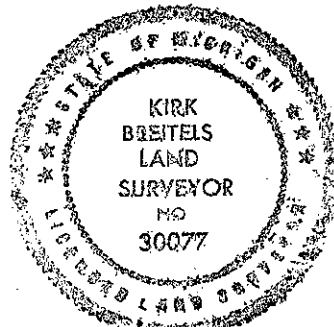

Signed by Kirk Breitels
Surveyor's Michigan License No. 30077

Date 3/27/97

P.A. 345 1990 KENT COUNTY
PEER APPROVED 3/27/97
CHAIRMAN [Signature]