

SURVEY & REMONUMENTATION

MAR 08 1999

LAND CORNER RECORDATION CERTIFICATE
 Filing Requirement of Act 74, Mich. P.A. 1970
 KENT COUNTY REMONUMENTATION

For corners in

SECTION

Kent (County)	Located in:	Vergennes Township	Corner Code #
1. Public Land Survey	T <u>7N</u>	R <u>9W</u>	<u>C-1</u>
	T _____	R _____	_____
	T _____	R _____	_____
	T _____	R _____	_____
2. Property Controlling in Section	S _____	T _____	R _____
	S _____	T _____	R _____
3. Miscellaneous Property in Sec.	S _____	T _____	R _____
	S _____	T _____	R _____

REG. OF DEEDS

David J. Board


98 OCT 23 AM 9:55

STATE OF MICHIGAN
 COUNTY OF KENT
 RECEIVED FOR RECORD

10736

Register of Deeds Stamp & File Number

- 4. Lot No. _____, Recorded Plat _____
- 5. Private Claims _____

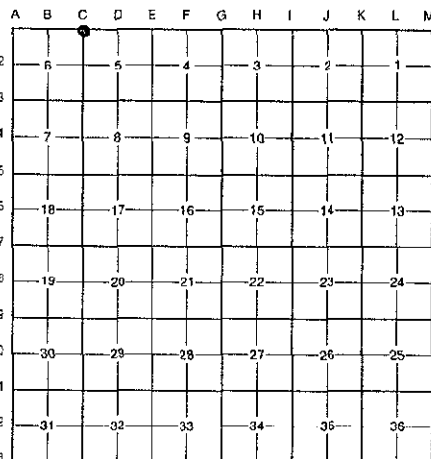

I, Randy Kolehouse, in a field survey on December 24 19 97, do hereby certify that under requirements of P.A. 74 Michigan P.A. of 1970, the corner points mentioned in lines 1 and 2 above were in conformance with regulations and rules therefore as required in the current manual of survey instructions of the United States Department of the interior, Bureau of Land Management or by a decree of a Court of Law and/or that the corner points mentioned in lines 3, 4 and 5 above were in conformance with the rules of the Michigan Board of Land Surveyors or by a Decree of a Court of Law; established, re-established, monumented, re-monumented, recovered, found as expressed below:

NOTE: Not more than 4 corners, all in the same town and range, may be recorded on this certificate.

A. Description of original monument and accessories and/or subsequent restoration:

C-1	1837	G.L.O. Notes	N. Brookfield	Set Post
	1959	Witness Map	K.C. Surveyor	Monument Box
	1975	L.C.R.C. #861	Medema, Van Kooten & Assoc.	"T" Iron in Mon. Box
	1986	L.C.R.C. #4355	R. Kolehouse	Fnd. "T" Iron in Mon. Box / Set K.C. Monument
	1994	L.C.R.C. #7983	Glaza & Associates	K.C. Monument

P.A. 345 1990 KENT COUNTY

PEER APPROVED 2/19/98

CHAIRMAN *[Signature]*

Note: This corner is not common with C-13, T8N, R9W.

This corner was originally approved by the Kent County Remonumentation Peer Group and monumented by R. Kolehouse on 1/15/86 and was recorded per L.C.R.C. #4355.

B. Description of corner evidence found and/or method applied in restoring or reestablishing corner:

C-1 Found a Standard Kent County Monument in a monument box 53' ± East of the C/L intersection of Parnell Avenue (bit.) running North and South and 4 Mile Road (gravel) running East per L.C.R.C.'s #4355 and #7983 as set by R. Kolehouse in place of a "T" iron he found in a monument box which checked L.C.R.C. #861 and the K.C. Surveyor's records.

L.C.R.C. #4355

L.C.R.C. #7983

Nail & K.C. Remon. tag in E face 30" Hickory N 60° W 94.73'
 Nail & K.C. Remon. tag in S side P. Pole N 75° E 107.65'
 NE cor. hse. fdn. S 70° E 121.22'
 C/L W side 10" Maple S 45° E 57.75'


Nail & K.C. remon tag in E side 36" Hickory N67°W 96.34'
 Nail & K.C. remon tag in S side P. pole N75°E 107.61' (m. 107.62')
 NE corner house foundation S70°E 121.23' (m. 121.21')
 Nail & K.C. remon tag in W side 12" Maple S45°E 57.70'

The selected location is accepted by me and is generally accepted by professional surveyors as the best available evidence of the position of the original corner.

C. Description of monument for corner and accessories established to perpetuate locating the position of the corner:

C-1 Standard Kent County Monument in a Monument Box

Nail & K.C. remon. tag on NE side 36" Hickory N 67° W 96.34'
 Nail & K.C. remon. tag on S side P. pole N 75° E 107.62'
 NE cor. hse. foundation S 70° E 121.21'
 Nail & K.C. remon. tag on W side cor. fence post N 12° W 61.25'
 C/L "X" of roads, West 53' ±
 K.C. Mon., C-13, T8N, R9W, West 115.40'

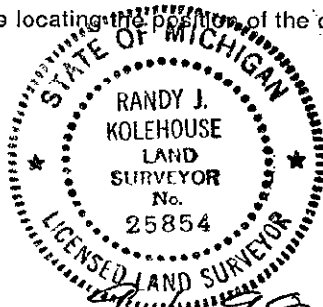

Signed by *[Signature]* Date 2/19/98

EARTH TECH

Surveyor's Michigan License No. 25854