

**SURVEY &
REMONUMENTATION**

MAR 08 1999

\$7.00
\$2.00

SECTION LAND CORNER RECORDATION CERTIFICATE
Filing Requirement of Act 74, Mich. P.A. 1970
KENT COUNTY REMONUMENTATION

For corners in

<u>Kent</u> (County)	Located in: Vergennes Township	Corner Code #
1. Public Land Survey	T <u>7N</u> R <u>9W</u>	<u>C-2</u>
	T _____ R _____	_____
	T _____ R _____	_____
	T _____ R _____	_____
2. Property Controlling in Section	S _____ T _____ R _____	_____
	S _____ T _____ R _____	_____
3. Miscellaneous Property in Sec.	S _____ T _____ R _____	_____
	S _____ T _____ R _____	_____


STATE OF MICHIGAN
COUNTY OF KENT
RECEIVED FOR RECORD
98 OCT 23 AM 9:55
REG. OF DEEDS
Tracy Stuber

10737

Register of Deeds Stamp & File Number

4. Lot No. _____, Recorded Plat _____
5. Private Claims _____

I, Randy Kolehouse, in a field survey on December 24 19 97, do hereby certify that under requirements of P.A. 74 Michigan P.A. of 1970, the corner points mentioned in lines 1 and 2 above were in conformance with regulations and rules therefore as required in the current manual of survey instructions of the United States Department of the interior, Bureau of Land Management or by a decree of a Court of Law and/or that the corner points mentioned in lines 3, 4 and 5 above were in conformance with the rules of the Michigan Board of Land Surveyors or by a Decree of a Court of Law; established, re-established, monumented, re-monumented, recovered, found as expressed below:

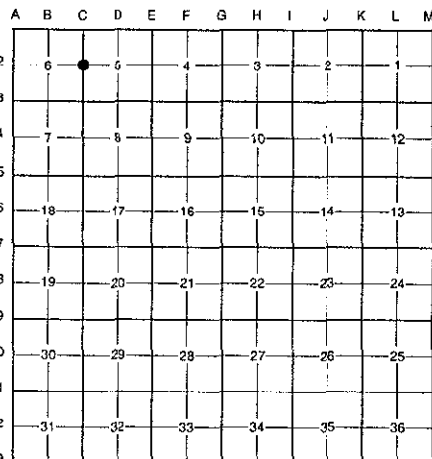

NOTE: Not more than 4 corners, all in the same town and range, may be recorded on this certificate.

A. Description of original monument and accessories and/or subsequent restoration:

C-2	1838	G.L.O. Notes	N. Brookfield	Set Post
	1959	Witness Map	K.C. Surveyor	Stone
	1975	L.C.R.C. #862	Medema, Van Kooten & Assoc.	"T" Iron in Mon. Box
	1981	L.C.R.C. #1907	Jonker Land Survey	Fnd. 1/2" Iron in Mon. Box / Set K.C. Monument in Mon. Box
	1991	L.C.R.C. #5798	R. Unema	K.C. Monument

P.A. 945 1990 KENT COUNTY
PEER APPROVED 2/19/98
CHAIRMAN Tracy Stuber

This corner was originally approved by the Kent County Remonumentation Peer Group and monumented by Rob Jonker on 6/22/81 and was recorded per L.C.R.C. #1907.

B. Description of corner evidence found and/or method applied in restoring or reestablishing corner:

C-2 Found a Standard Kent County Monument in a monument box 3' West of the C/L of Parnell Avenue (bit.) running North and South on line of a tree row running East per L.C.R.C.'s #1907 and #5798 as set by Rob Jonker in place of a 1/2" round iron he found in a monument box which checked L.C.R.C. #862 and the K.C. Surveyor's records.

L.C.R.C. #1907

L.C.R.C. #5798


Remon. tag on S side 14" Maple S88°E 64.63'	Nail & remon tag on NE side 20" Elm S 50°E 39.86' (m. 39.88')
Remon. tag on N side 10" Elm S53°E 39.72'	Nail & remon tag in S side 16" Maple S 85°E 64.65' (m. 64.67')

The selected location is accepted by me and is generally accepted by professional surveyors as the best available evidence of the position of the original corner.

C. Description of monument for corner and accessories established to perpetuate locating the position of the corner:

C-2 Standard Kent County Monument in a Monument Box

- Nail & K.C. remon. tag on NE side stump S 50° E 39.88'
- Nail & K.C. remon. tag on S side 16" Maple S 85° E 64.67'
- Nail & K.C. remon. tag on W side 14" stump S 10° E 135.61'
- Rebar N 23° W 40.77'
- Rebar S 30° W 41.75'
- C/L bit. road running N-S, East 3.0'
- On tree row running E

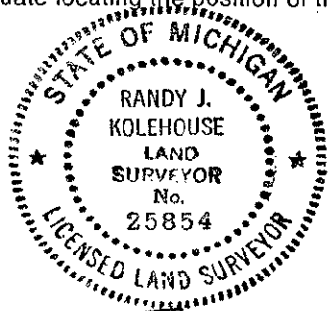

Signed by Randy J. Kolehouse
EARTH TECH

Date 9-1-98

Surveyor's Michigan License No. 25854