

SURVEY & REMONUMENTATION

MAR 08 1999

\$7.00
\$2.00

SECTION LAND CORNER RECORDATION CERTIFICATE
Filing Requirement of Act 74, Mich. P.A. 1970
KENT COUNTY REMONUMENTATION

STATE OF MICHIGAN
COUNTY OF KENT
RECEIVED FOR RECORD
98 OCT 23 AM 9:55
REG. OF DEEDS
Lucy Stoddard

For corners in


Kent (County)	Located in: Vergennes Township	Corner Code #
1. Public Land Survey	T <u>7N</u> R <u>9W</u>	<u>C-3</u>
	T _____ R _____	_____
	T _____ R _____	_____
	T _____ R _____	_____
2. Property Controlling in Section	S _____ T _____ R _____	_____
	S _____ T _____ R _____	_____
3. Miscellaneous Property in Sec.	S _____ T _____ R _____	_____
	S _____ T _____ R _____	_____

10738

Register of Deeds Stamp & File Number

4. Lot No. _____, Recorded Plat _____
5. Private Claims _____

I, Randy Kolehouse, in a field survey on December 24 19 97, do hereby certify that under requirements of P.A. 74 Michigan P.A. of 1970, the corner points mentioned in lines 1 and 2 above were in conformance with regulations and rules therefore as required in the current manual of survey instructions of the United States Department of the interior, Bureau of Land Management or by a decree of a Court of Law and/or that the corner points mentioned in lines 3, 4 and 5 above were in conformance with the rules of the Michigan Board of Land Surveyors or by a Decree of a Court of Law; established, re-established, monumented, re-monumented, recovered, found as expressed below:

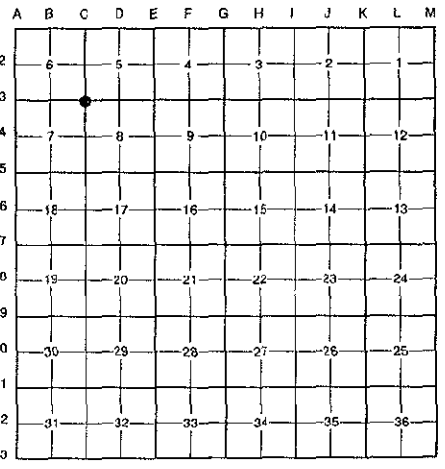

NOTE: Not more than 4 corners, all in the same town and range, may be recorded on this certificate.

A. Description of original monument and accessories and/or subsequent restoration:

C-3	Date	Description	Surveyor	Monument
1838		G.L.O. Notes	N. Brookfield	Set Post
1959		Witness Map	K.C. Surveyor	Monument Box
1983		L.C.R.C. #3293	Glaza & Associates	Iron in Mon. Box
1983		L.C.R.C. #3446	G. Fauser	5/8" Pipe in Mon. Box
1983		L.C.R.C. #3452	Williams & Works	Fnd. 3/4" Iron in Mon. Box / Set K.C. Monument
1991		L.C.R.C. #5799	Exxel Engineering	K.C. Monument

P.A. 345 1990 KENT COUNTY
PEER APPROVED 2/19/98
CHAIRMAN Henry Huber

This corner was originally approved by the Kent County Remonumentation Peer Group and monumented by Williams & Works on 7/7/83 and was recorded per L.C.R.C. #3452.

B. Description of corner evidence found and/or method applied in restoring or reestablishing corner:


C-3 Found a Standard Kent County Monument in a monument box 1' West of the C/L of Parnell Avenue (bit.) running North and South and 2' ± South of the C/L of 3 Mile Road (gravel) running East and West per L.C.R.C.'s #3452 and #5799 as set by Williams & Works in place of a 3/4" iron they found in a monument box which checked L.C.R.C.'s #3446, #3293 and the K.C. Surveyor's records.

L.C.R.C. #3452	L.C.R.C. #5799
Nail & KC Remon.tag in W side 20" Maple N 20°W 104.10'	Nail & remon tag in E side 30" Maple N 18°W 104.17'
Nail & KC Remon.tag in N side Power pole S 65°W 78.25'	Nail & remon tag in N side P.Pole S 76°W 78.24' (m. 78.19')
Nail & KC Remon.tag in N side Power pole S80°E 141.65'	Nail & remon tag in N side P.Pole S 76°E 141.63' (m. 141.59')
	Nail & remon tag in NW side 6" Maple N 61°E 83.18' (m. 83.21')

The selected location is accepted by me and is generally accepted by professional surveyors as the best available evidence of the position of the original corner.

C. Description of monument for corner and accessories established to perpetuate location and the position of the corner:

- C-3 Standard Kent County Monument in a Monument Box
- Nail & K.C. remon. tag on E side 30" Maple N 18° W 104.17'
 - Nail & K.C. remon. tag on N side P. pole S 76° W 78.19'
 - Nail & K.C. remon. tag on N side P. pole S 76° E 141.59'
 - Nail & K.C. remon. tag on NW side 12" Maple N 61° E 83.21'
 - C/L bit. road running N-S, East 1.0'
 - C/L gravel road running E-W, North 2.0' ±

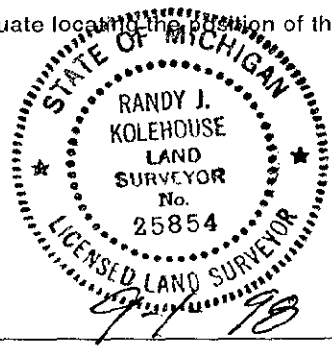

Signed by Randy J. Kolehouse Date 2/19/98

Surveyor's Michigan License No. 25854