

MAR 9 8 1999

SECTION

LAND CORNER RECORDATION CERTIFICATE
Filing Requirement of Act 74, Mich. P.A. 1970
KENT COUNTY REMONUMENTATION

For corners in

Kent (County)	Located in: Vergennes Township	Corner Code #
1. Public Land Survey	T <u>7N</u> R <u>9W</u>	<u>C-4</u>
	T _____ R _____	_____
	T _____ R _____	_____
	T _____ R _____	_____
2. Property Controlling in Section	S _____ T _____ R _____	_____
	S _____ T _____ R _____	_____
3. Miscellaneous Property in Sec.	S _____ T _____ R _____	_____
	S _____ T _____ R _____	_____

4. Lot No. _____, Recorded Plat _____
 5. Private Claims _____

STATE OF MICHIGAN
COUNTY OF KENT
RECEIVED FOR RECORD


98 OCT 23 AM 9:55

REG. OF DEEDS

10739

Register of Deeds Stamp & File Number

I, Randy Kolehouse, in a field survey on December 24 19 97, do hereby certify that under requirements of P.A. 74 Michigan P.A. of 1970, the corner points mentioned in lines 1 and 2 above were in conformance with regulations and rules therefore as required in the current manual of survey instructions of the United States Department of the Interior, Bureau of Land Management or by a decree of a Court of Law and/or that the corner points mentioned in lines 3, 4 and 5 above were in conformance with the rules of the Michigan Board of Land Surveyors or by a Decree of a Court of Law; established, re-established, monumented, re-monumented, recovered, found as expressed below:

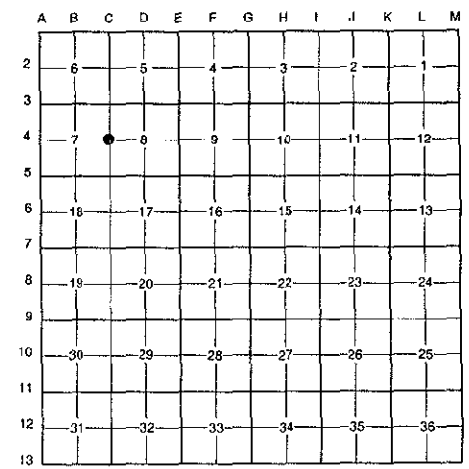

NOTE: Not more than 4 corners, all in the same town and range, may be recorded on this certificate.

A. Description of original monument and accessories and/or subsequent restoration:

C-4	1838	G.L.O. Notes	N. Brookfield	Set Post
	1929	Witness Map	K.C. Surveyor	1-1/4" Iron Pipe & Stone
	1983	L.C.R.C. #3546	T. Chettleburgh	Fnd. RR Spike / Set K.C. Monument
	1991	L.C.R.C. #5800	Exxel Engineering	K.C. Monument

P.A. 345 1990 KENT COUNTY
 PEER APPROVED 2/19/98
 CHAIRMAN [Signature]

This corner was originally approved by the Kent County Remonumentation Peer Group and monumented by T. Chettleburgh on 8/9/83 and was recorded per L.C.R.C. #3546.

B. Description of corner evidence found and/or method applied in restoring or reestablishing corner:


C-4 Found a Standard Kent County Monument on the C/L of Parnell Avenue (bit.) running North and South, on line of a tree row running East, per L.C.R.C.'s #3546 and #5800 as set by T. Chettleburgh in place of a RR spike he found which checked the K.C. Surveyor's records.

L.C.R.C. #3546	L.C.R.C. #5800
Nail in NW side 8" Maple NE 31.87'	Nail & remon tag in N side twin 24" Maple S 44°E 65.71' (m. 65.69')
Nail in NE side Tw 20" Maple SE 65.71'	Nail & remon tag in S side 16" Ash S 49°W 46.50'
Nail in SE side 14" Ash SW 46.51'	Nail & remon tag in N side 22" Maple N 58°W 90.26' (m. 90.18')
Nail in NE side 19" Maple NW 90.23'	

The selected location is accepted by me and is generally accepted by professional surveyors as the best available evidence of the position of the original corner.

C. Description of monument for corner and accessories established to perpetuate locating the position of the corner:

- C-4 Standard Kent County Monument
- Nail & K.C. remon. tag on N side 24" Twin Maple S 44° E 65.69'
 - Nail & K.C. remon. tag on S side 16" Ash S 49° W 46.50'
 - Nail & K.C. remon. tag on N side 22" Maple N 58° W 90.18'
 - Nail & K.C. remon. tag on S side 10" Maple S 82° W 28.34'
 - On C/L bit. road running N-S
 - On tree row running E

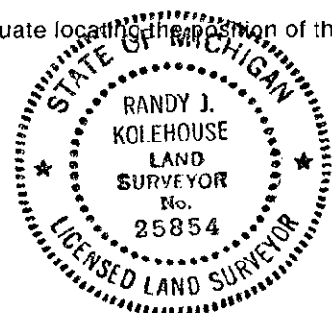

Signed by [Signature]
 EARTH TECH

Date 9-1-98

Surveyor's Michigan License No. 25854