

\$7.00  
\$2.00

SURVEY &  
REMONUMENTATION

MAR 08 1999

LAND CORNER RECORDATION CERTIFICATE  
Filing Requirement of Act 74, Mich. P.A. 1970

KENT COUNTY REMONUMENTATION

For corners in

SECTION

| Kent<br>(County)                      | Located in: | Vergennes<br>Township | Corner Code # |
|---------------------------------------|-------------|-----------------------|---------------|
| 1. Public Land Survey                 | T <u>7N</u> | R <u>9W</u>           | <u>C-5</u>    |
|                                       | T _____     | R _____               | _____         |
|                                       | T _____     | R _____               | _____         |
|                                       | T _____     | R _____               | _____         |
| 2. Property Controlling<br>in Section | S _____     | R _____               | _____         |
|                                       | S _____     | R _____               | _____         |
| 3. Miscellaneous<br>Property in Sec.  | S _____     | R _____               | _____         |
|                                       | S _____     | R _____               | _____         |

STATE OF MICHIGAN  
COUNTY OF KENT  
RECEIVED FOR RECORD


38 OCT 23 AM 9:55  
10:40

REG. OF DEEDS  
*David J. ...*

Register of Deeds Stamp & File Number

- 4. Lot No. \_\_\_\_\_, Recorded Plat \_\_\_\_\_
- 5. Private Claims \_\_\_\_\_

I, Randy Kolehouse, in a field survey on December 26 19 97, do hereby certify that under requirements of P.A. 74 Michigan P.A. of 1970, the corner points mentioned in lines 1 and 2 above were in conformance with regulations and rules therefore as required in the current manual of survey instructions of the United States Department of the interior, Bureau of Land Management or by a decree of a Court of Law and/or that the corner points mentioned in lines 3, 4 and 5 above were in conformance with the rules of the Michigan Board of Land Surveyors or by a Decree of a Court of Law; established, re-established, monumented, re-monumented, recovered, found as expressed below:

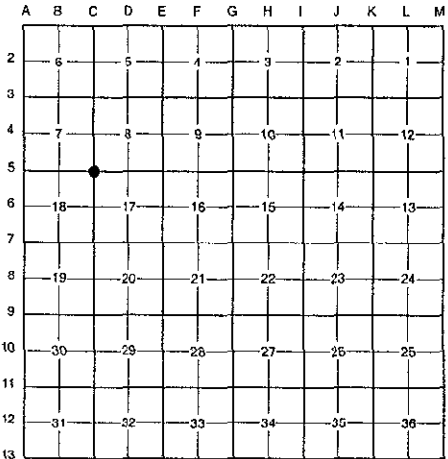

**NOTE:** Not more than 4 corners, all in the same town and range, may be recorded on this certificate.

A. Description of original monument and accessories and/or subsequent restoration:

| C-5 | 1838 | G.L.O. Notes   | N. Brookfield     | Set Post                                       |
|-----|------|----------------|-------------------|--|
|     | 1965 | Witness Map    | K.C. Surveyor     | 3/4" Iron in Mon. Box                          |
|     | 1976 | L.C.R.C. #937  | J. Clapp          | "T" Iron                                       |
|     | 1983 | L.C.R.C. #3545 | T. Chettleburgh   | Fnd. 3/4" Iron in Mon. Box / Set K.C. Monument |
|     | 1991 | L.C.R.C. #5801 | Exxel Engineering | K.C. Monument                                  |

P.A. 345 1990 KENT COUNTY  
PEER APPROVED 2/19/98  
*Randy Kolehouse*  
CHAIRMAN

This corner was originally approved by the Kent County Remonumentation Peer Group and monumented by T. Chettleburgh on 8/9/83 and was recorded per L.C.R.C. #3545.


B. Description of corner evidence found and/or method applied in restoring or reestablishing corner:

| C-5 | Found a Standard Kent County Monument in a monument box at the C/L intersection of Parnell Avenue (bit.) running North and South and 2 Mile Road (bit.) running East and West per L.C.R.C.'s #3545 and #5801 as set by T. Chettleburgh in place of a 3/4" iron pipe he found in a monument box which checked L.C.R.C. #937 and the K.C. Surveyor's records. |
|-----|---|
|     | L.C.R.C. #3545<br>Nail in N side 9" Hickory ESE 106.81'<br>Nail in E side 16" Hickory SSW 140.62'   |
|     | L.C.R.C. #5801<br>Nail & remon tag in E side 18" Hickory S 17°W 140.65' (m. 140.61')<br>Nail & remon tag in N side 12" Hickory S 65°E 106.80' (m. 106.79')<br>Nail & remon tag in W side 8" Elm N 30°E 80.55' (m. 80.59')   |

The selected location is accepted by me and is generally accepted by professional surveyors as the best available evidence of the position of the original corner.

C. Description of monument for corner and accessories established to perpetuate locating the position of the corner:

| C-5 | Standard Kent County Monument in a Monument Box              |
|-----|--|
|     | Nail & K.C. remon. tag on NE side P. pole S 55° E 78.81'     |
|     | Nail & K.C. remon. tag on E side 18" Hickory S 17° W 140.61' |
|     | Nail & K.C. remon. tag on SW side P. pole N 45° W 73.08'     |
|     | Nail & K.C. remon. tag on N side 12" Hickory S 65° E 106.79' |
|     | Nail & K.C. remon. tag on W side 8" Elm N 30° E 80.59'       |
|     | On C/L "X" of bit. roads running N, S, E & W                 |

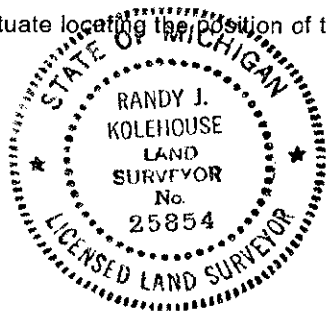

Signed by *Randy J. Kolehouse* Date 9-1-98  
EARTH TECH  
Surveyor's Michigan License No. 25854