

MAR 08 1999

SECTION LAND CORNER RECORDATION CERTIFICATE
Filing Requirement of Act 74, Mich. P.A. 1970
KENT COUNTY REMONUMENTATION

STATE OF MICHIGAN
COUNTY OF KENT
RECEIVED FOR RECORD
98 OCT 23 AM 9:55
REG. OF DEEDS

10743

Register of Deeds Stamp & File Number

For corners in

Table with columns: Kent (County), Located in: Vergennes Township, Corner Code #. Rows include Public Land Survey, Property Controlling in Section, Miscellaneous Property in Sec.

4. Lot No. , Recorded Plat
5. Private Claims


I, Randy Kolehouse, in a field survey on January 2, 1998, do hereby certify that under requirements of P.A. 74 Michigan P.A. of 1970, the corner points mentioned in lines 1 and 2 above were in conformance with regulations and rules therefore as required in the current manual of survey instructions of the United States Department of the interior, Bureau of Land Management or by a decree of a Court of Law and/or that the corner points mentioned in lines 3, 4 and 5 above were in conformance with the rules of the Michigan Board of Land Surveyors or by a Decree of a Court of Law; established, re-established, monumented, re-monumented, recovered, found as expressed below:

NOTE: Not more than 4 corners, all in the same town and range, may be recorded on this certificate.

A. Description of original monument and accessories and/or subsequent restoration:

Table with columns: C-8, 1838, G.L.O. Notes, N. Brookfield, Set Post, 1962, Witness Map, K.C. Surveyor, 1-1/2" Pipe, 1973, L.C.R.C. #515, Exxel Engineering, "T" Iron, 1974, L.C.R.C. #737, J. Clapp, "T" Iron, 1981, L.C.R.C. #1933, Jonker Land Survey, Fnd. "T" Iron / Set K.C. Monument, 1991, L.C.R.C. #5804, Exxel Engineering, K.C. Monument

P.A. 345 1990 KENT COUNTY
PEER APPROVED 2/19/98
CHAIRMAN Randy Kolehouse

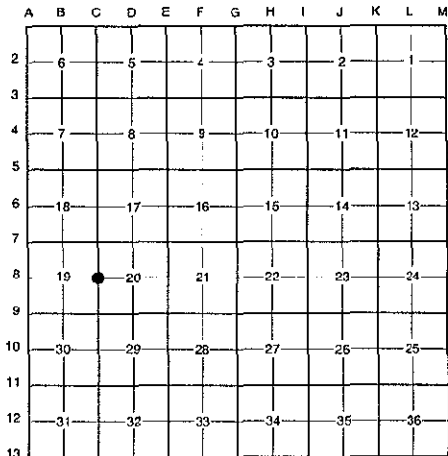

This corner was originally approved by the Kent County Remonumentation Peer Group and monumented by Rob Jonker on 6/22/81 and was recorded per L.C.R.C. #1933.

B. Description of corner evidence found and/or method applied in restoring or reestablishing corner:

C-8 Found a Standard Kent County Monument 1.0' East of the C/L of Parnell Avenue (bit.) running North and South per L.C.R.C.'s #1933 and #5804 as set by Rob Jonker in place of a "T" iron he found at grade inside of a 2"x30" pipe 15" below grade which checked L.C.R.C.'s #737, #515 and the K.C. Surveyor's records.

L.C.R.C. #1933

- Remon. tag on S. side p. pole S 59°E 54.44'
Remon. tag on E. side 16" Hickory N 24°W 75.00'
Remon. tag on NE side 38" Oak N 41°W 52.72'
Remon. tag on SW side 12" Elm S 61°W 41.75'


L.C.R.C. #5804

- Nail & remon tag in SW side P.Pole S 60°E 54.42' (m. 54.39')
Nail & remon tag in NE side 38" Oak N 40°W 52.72' (m. 52.59')
Nail & remon tag in NW side 12" Elm N 50°E 39.29' (m. 39.34')
Nail & remon tag in N side 16" Elm S 60°W 41.56' (m. 41.48')
1/2" iron w/cap S 85°E 33.00' (m. 33.02')
Nail & remon tag in E side 18" Hickory N 22°W 75.00' (m. 75.04')

The selected location is accepted by me and is generally accepted by professional surveyors as the best available evidence of the position of the original corner.

C. Description of monument for corner and accessories established to perpetuate location of the position of the corner:

- C-8 Standard Kent County Monument
Nail & K.C. remon. tag on SW side P. pole S 60° E 54.39'
Nail & K.C. remon. tag on NE side 38" Oak N 40° W 52.69'
Nail & K.C. remon. tag on NW side 16" Elm N 50° E 39.34'
Nail & K.C. remon. tag on N side 16" Elm S 60° W 41.48'
1/2" iron with cap S 85° E 33.02'
On C/L bit. road running N-S

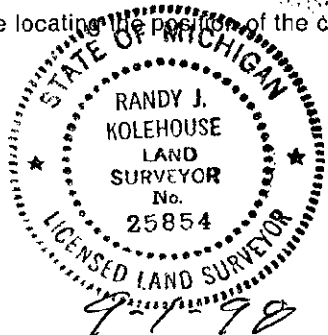

Signed by Randy J. Kolehouse

Date 9-1-98

Surveyor's Michigan License No. 25854