

MAR 08 1999

\$7.00
\$2.00

LAND CORNER RECORDATION CERTIFICATE
Filing Requirement of Act 74, Mich. P.A. 1970
KENT COUNTY REMONUMENTATION

SECTION

For corners in

Kent (County)	Located in: Vergennes Township	Corner Code #
1. Public Land Survey	T <u>7N</u> R <u>9W</u>	<u>C-9</u>
	T _____ R _____	_____
	T _____ R _____	_____
	T _____ R _____	_____
2. Property Controlling in Section	S _____ T _____ R _____	_____
	S _____ T _____ R _____	_____
3. Miscellaneous Property in Sec.	S _____ T _____ R _____	_____
	S _____ T _____ R _____	_____

REG. OF DEEDS

Handwritten signature

38 OCT 23 AM 9:55

STATE OF MICHIGAN
COUNTY OF KENT
RECEIVED FOR RECORD

10744

Register of Deeds Stamp & File Number


4. Lot No. _____, Recorded Plat _____
5. Private Claims _____

I, Randy Kolehouse, in a field survey on January 2 19 98, do hereby certify that under requirements of P.A. 74 Michigan P.A. of 1970, the corner points mentioned in lines 1 and 2 above were in conformance with regulations and rules therefore as required in the current manual of survey instructions of the United States Department of the interior, Bureau of Land Management or by a decree of a Court of Law and/or that the corner points mentioned in lines 3, 4 and 5 above were in conformance with the rules of the Michigan Board of Land Surveyors or by a Decree of a Court of Law; established, re-established, monumented, re-monumented, recovered, found as expressed below:

NOTE: Not more than 4 corners, all in the same town and range, may be recorded on this certificate.

A. Description of original monument and accessories and/or subsequent restoration:

C-9	1838	G.L.O. Notes	N. Brookfield	Set Post
	1958	Witness Map	K.C. Surveyor	2" Iron
	1973	L.C.R.C. #515	Exxel Engineering	"T" Iron in Mon. Box
	1974	L.C.R.C. #737	J. Clapp	Monument Box
	1977	L.C.R.C. #984	Moore & Bruggink	"T" Iron in Monument Box
	1981	L.C.R.C. #1910	Jonker Land Survey	Fnd. "T" Iron in Mon. Box / Set K.C. Monument in Mon. Box
	1991	L.C.R.C. #5805	Exxel Engineering	K.C. Monument

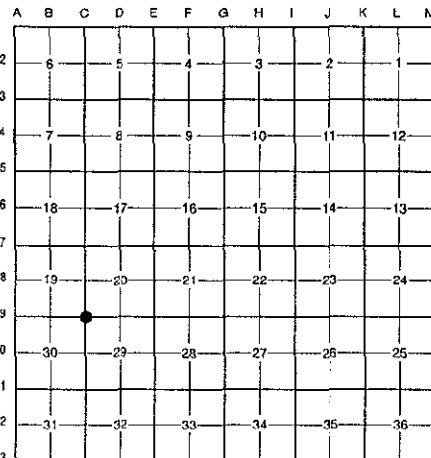

P.A. 345 1990 KENT COUNTY

PEER APPROVED 2/19/98

CHAIRMAN *Handwritten signature*

This corner was originally approved by the Kent County Remonumentation Peer Group and monumented by Rob Jonker on 7/8/81 and was recorded per L.C.R.C. #1910.

B. Description of corner evidence found and/or method applied in restoring or reestablishing corner:

C-9 Found a Standard Kent County Monument in a monument box at the C/L intersection of Parnell Avenue (bit.) running North and South and Bailey Drive (bit.) running East and West per L.C.R.C.'s #1910 and #5805 as set by Rob Jonker in place of a "T" iron he found in a monument box at grade inside of a 3"x30" pipe 8" below grade which checked L.C.R.C.'s #984, #737 and the K.C. Surveyor's records.

L.C.R.C. #1910

L.C.R.C. #5805

Remon. tag on E side t. pole S45°W 76.40'
SE cor. twp. hall fnd. N39°W 67.73'
SW cor. church fnd. N52°E 79.45'


Nail & remon tag in E side T.Pole S 45°W 76.40' (m. 76.39')
SE cor Twp. Hall fndn. N 42°W 67.73' (m. 67.74')
SW cor church fndn. 0.2' below wood siding N 53°E 79.30' (m. 79.31')

The selected location is accepted by me and is generally accepted by professional surveyors as the best available evidence of the position of the original corner.

C. Description of monument for corner and accessories established to perpetuate localing the position of the corner:

C-9 Standard Kent County Monument in a Monument Box

Nail & K.C. remon. tag on E side T. pole S 45° W 76.39'
SE cor. Twp. Hall fndn. N 42° W 67.74'
SW cor. church fndn. 0.2' below wood siding N 53° E 79.31'
Nail & K.C. remon. tag on NE side P. pole S 16° E 87.71'
On C/L "X" of bit. roads running N, S, E & W

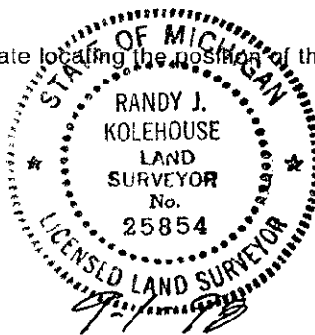

Signed by *Handwritten signature of Randy J. Kolehouse*

Date _____

EARTH TECH

Surveyor's Michigan License No. 25854