

MAR 08 1999

\$7.00
\$2.00

SECTION

LAND CORNER RECORDATION CERTIFICATE
Filing Requirement of Act 74, Mich. P.A. 1970
KENT COUNTY REMONUMENTATION

REG. OF DEEDS

Luis J. Stand

38 OCT 23 AM 9:55

STATE OF MICHIGAN
COUNTY OF KENT
RECEIVED FOR RECORD

For corners in

Kent (County)	Located in: Vergennes Township	Corner Code #
1. Public Land Survey	T <u>7N</u> R <u>9W</u>	<u>C-10</u>
	T _____ R _____	_____
	T _____ R _____	_____
	T _____ R _____	_____
2. Property Controlling in Section	S _____ T _____ R _____	_____
	S _____ T _____ R _____	_____
3. Miscellaneous Property in Sec.	S _____ T _____ R _____	_____
	S _____ T _____ R _____	_____

10745

Register of Deeds Stamp & File Number

- 4. Lot No. _____, Recorded Plat _____
- 5. Private Claims _____


I, Randy Kolehouse, in a field survey on January 5 19 98, do hereby certify that under requirements of P.A. 74 Michigan P.A. of 1970, the corner points mentioned in lines 1 and 2 above were in conformance with regulations and rules therefore as required in the current manual of survey instructions of the United States Department of the interior, Bureau of Land Management or by a decree of a Court of Law and/or that the corner points mentioned in lines 3, 4 and 5 above were in conformance with the rules of the Michigan Board of Land Surveyors or by a Decree of a Court of Law; established, re-established, monumented, re-monumented, recovered, found as expressed below:

NOTE: Not more than 4 corners, all in the same town and range, may be recorded on this certificate.

A. Description of original monument and accessories and/or subsequent restoration:

C-10	1838	G.L.O. Notes	N. Brookfield	Set Post
	1958	Witness Map	K.C. Surveyor	Iron
	1975	L.C.R.C. #916	E. McCombs	1/2" Pipe
	1977	L.C.R.C. #984	Moore & Bruggink	Iron
	1981	L.C.R.C. #1926	Jonker Land Survey	Fnd. 1/2" Round Iron / Set K.C. Monument
	1991	L.C.R.C. #5806	Exxel Engineering	K.C. Monument

P.A. 345 1990 KENT COUNTY
PEER APPROVED 2/19/98
CHAIRMAN *Harry Huber*

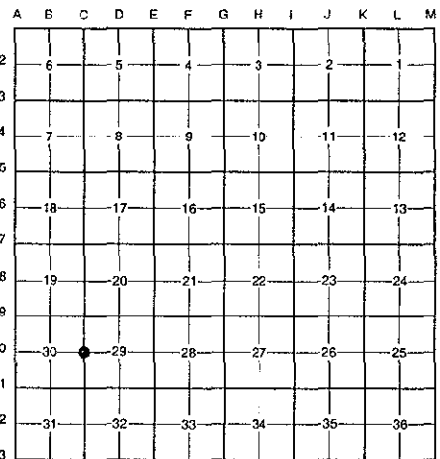

This corner was originally approved by the Kent County Remonumentation Peer Group and monumented by Rob Jonker on 7/10/81 and was recorded per L.C.R.C. #1926.

B. Description of corner evidence found and/or method applied in restoring or reestablishing corner:

C-10 Found a Standard Kent County Monument on the C/L of Parnell Avenue (bit.) running North and South on line of a tree row and fence line running East and a tree row running West per L.C.R.C.'s #1926 and #5806 as set by Rob Jonker in place of a 1/2" round iron he found at grade over a 2"x30" round pipe 13" below grade which checked L.C.R.C.'s #984, #916 and the K.C. Surveyor's records.

L.C.R.C. #1926

L.C.R.C. #5806

Remon. tag on N side 34" Oak N76°W 49.62'
Remon. tag on NE side 16" Oak N38°W 62.90'
Remon. tag on E side 18" Oak S38°W 52.15'
Remon. tag on SW side p.pole S26°E 71.7'

Nail & remon tag in N side 36" Oak N 75°W 49.64' (m. 49.65')
Nail & remon tag in NE side 16" Oak N 37°W 62.89' (m. 62.79')
Nail & remon tag in E side 28" Oak S 38°W 52.18' (m. 52.20')
Capped iron E. 33.00' (m. 33.02')

The selected location is accepted by me and is generally accepted by professional surveyors as the best available evidence of the position of the original corner.

C. Description of monument for corner and accessories established to perpetuate locating the position of the corner:

C-10 Standard Kent County Monument

Nail & K.C. remon. tag on N side 36" Oak N 75° W 49.65'
Nail & K.C. remon. tag on NE side 16" Oak N 37° W 62.79'
Nail & K.C. remon. tag on E side 28" Oak S 38° W 52.20'
Nail & K.C. remon. tag on SW side P. pole S 26° E 91.74'
Capped iron East 33.02'

On C/L of bit. road running N-S
On tree row and fence line running E
On tree row running W

Signed by *Randy J. Kolehouse* Date 9-1-98

EARTH TECH

Surveyor's Michigan License No. 25854

