

SURVEY & REMONUMENTATION

MAR 08 1999

LAND CORNER RECORDATION CERTIFICATE
Filing Requirement of Act 74, Mich. P.A. 1970
KENT COUNTY REMONUMENTATION

SECTION

For corners in

Kent (County)	Located in: Vergennes Township	Corner Code #
1. Public Land Survey	T <u>7N</u> R <u>9W</u>	<u>C-11</u>
	T _____ R _____	_____
	T _____ R _____	_____
	T _____ R _____	_____
2. Property Controlling in Section	S _____ T _____ R _____	_____
	S _____ T _____ R _____	_____
3. Miscellaneous Property in Sec.	S _____ T _____ R _____	_____
	S _____ T _____ R _____	_____

4. Lot No. _____, Recorded Plat _____
 5. Private Claims _____

STATE OF MICHIGAN
 COUNTY OF KENT
 RECEIVED FOR RECORD
 98 OCT 23 AM 9:55
 REG. OF DEEDS
Lucy Storch

10746


Register of Deeds Stamp & File Number

I, Randy Kolehouse, in a field survey on January 5 19 98, do hereby certify that under requirements of P.A. 74 Michigan P.A. of 1970, the corner points mentioned in lines 1 and 2 above were in conformance with regulations and rules therefore as required in the current manual of survey instructions of the United States Department of the interior, Bureau of Land Management or by a decree of a Court of Law and/or that the corner points mentioned in lines 3, 4 and 5 above were in conformance with the rules of the Michigan Board of Land Surveyors or by a Decree of a Court of Law; established, re-established, monumented, re-monumented, recovered, found as expressed below:

NOTE: Not more than 4 corners, all in the same town and range, may be recorded on this certificate.

A. Description of original monument and accessories and/or subsequent restoration:

C-11	1838	G.L.O. Notes	N. Brookfield	Set Post
	1943-58	Witness Map	K.C. Surveyor	1/2" Iron
	1975	L.C.R.C. #918	E. McCombs	3/4" Pipe
	1978	L.C.R.C. #1157	D. Armock	1/2" Iron
	1981	L.C.R.C. #1911	Jonker Land Survey	Fnd. 1/2" Iron / Set K.C. Monument
	1991	L.C.R.C. #5807	Exxel Engineering	K.C. Monument

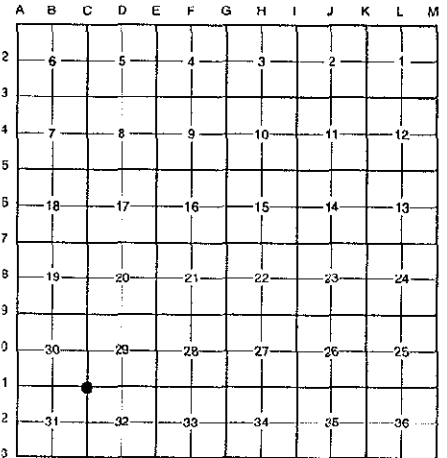

P.A. 345 1990 KENT COUNTY
PEER APPROVED 2/19/98
CHAIRMAN *Randy Kolehouse*

This corner was originally approved by the Kent County Remonumentation Peer Group and monumented by Rob Jonker on 7/8/81 and was recorded per L.C.R.C. #1911.

B. Description of corner evidence found and/or method applied in restoring or reestablishing corner:

C-11 Found a Standard Kent County Monument at the C/L intersection of Parnell Avenue (bit.) running North and South and Vergennes Street (bit.) running East and West per L.C.R.C.'s #1911 and #5807 as set by Rob Jonker in place of a 1/2" iron he found at grade and a 3/4" iron 1.1' below grade which checked L.C.R.C.'s #1157, #918 and the K.C. Surveyor's records.

L.C.R.C. #1911

L.C.R.C. #5807

Remon. tag on NW side P.pole N37°E 61.98'
 Remon. tag on S side P.pole N66°W 136.50'
 Remon. tag on NW side 30" Locust N70°E 70.66'


Nail & remon tag in NW side 30" Locust N 71°E 70.28' (m. 70.19')
 Nail & remon tag in NW side P.Pole N 38°E 61.97' (m. 62.00')
 Nail & remon tag in E side T.Pole S 25°W 58.48' (m. 48.89')
 Nail & remon tag in S side P.Pole N 65°W 136.46' (m. 136.49')

The selected location is accepted by me and is generally accepted by professional surveyors as the best available evidence of the position of the original corner.

C. Description of monument for corner and accessories established to perpetuate locating the position of the corner:

C-11 Standard Kent County Monument

- Nail & K.C. remon. tag on NW side 30" Locust N 71° E 70.19'
- Nail & K.C. remon. tag on NW side P. pole N 38° E 62.00'
- Nail & K.C. remon. tag on E side T. pole S 44° W 48.89'
- Nail & K.C. remon. tag on S side P. pole N 65° W 136.49'
- On C/L "X" of bit. roads running N, S, E & W

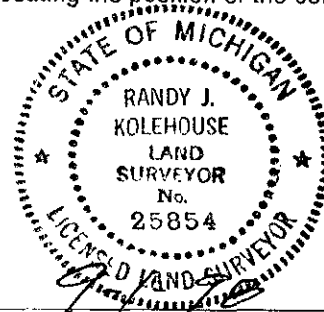

Signed by *Randy J. Kolehouse* Date _____
 EARTH TECH

Surveyor's Michigan License No. 25854