

**SURVEY & REMONUMENTATION**

**MAR 03 1998**

**KENT COUNTY REMONUMENTATION**

STATE OF MICHIGAN  
COUNTY OF KENT  
RECEIVED FOR RECORD

97 APR 29 AM 8:28

**SECTION**

**LAND CORNER RECORDATION CERTIFICATE**  
Filing Requirement of Act 74, Mich. P.A. 1970

For corners in  
**KENT COUNTY**

Located In: Corner Code #

1. Public Land Survey	T <u>7N</u> R <u>9W</u>	C-13
	T <u>    </u> R <u>    </u>	<u>    </u>
	T <u>    </u> R <u>    </u>	<u>    </u>
	T <u>    </u> R <u>    </u>	<u>    </u>
2. Property Controlling in Section	S <u>    </u> T <u>    </u> R <u>    </u>	<u>    </u>
	S <u>    </u> T <u>    </u> R <u>    </u>	<u>    </u>
3. Miscellaneous Property in Sec.	S <u>    </u> T <u>    </u> R <u>    </u>	<u>    </u>
	S <u>    </u> T <u>    </u> R <u>    </u>	<u>    </u>

*W. J. Bond*  
REG. OF DEEDS

**9901**

Register of Deeds Stamp & File Number

4. Lot No. \_\_\_\_\_, Recorded Plat \_\_\_\_\_  
5. Private Claims \_\_\_\_\_

I, Kirk Breitels, in a field survey on Jan. 6, 1997 do hereby state that under requirements of P.A. 74, Michigan P.A. of 1970, the corner points mentioned in lines 1 and 2 above were in conformance with regulations and rules therefore as required in the current manual of survey instructions of the United States Department of the Interior, Bureau of Land Management or by a decree of a Court of Law and /or that the corner points mentioned in lines 3, 4 and 5 above were in conformance with the rules of the Michigan Board of Land Surveyors or by a Decree of a Court of Law; established, re-established, monumented, recovered, found as expressed below:

NOTE: Not more than 2 corners, all in the same town and range, may be recorded on this certificate.

A	B	C	D	E	F	G	H	I	J	K	L	M
1												
2	6	5	4	3	2	1						
3												
4	7	8	9	10	11	12						
5												
6	18	17	16	15	14	13						
7												
8	19	20	21	22	23	24						
9												
10	30	29	28	27	26	25						
11												
12	31	32	33	34	35	36						
13												

A. Description of original monument and accessories and/or subsequent restoration:

C-13	1830	GLO	Mullett	Set Post
	1970	Kent Co. Wit.		Iron
	1975	LCRC #917	McCombs	1" Pipe
	1978	LCRC #1168	Merdzinski	1" Iron
	1981	LCRC #1765	Merdzinski	Set Kent County Monument in Mon. Box
	1991	LCRC #5809	Unema	Kent County Monument

The position of this corner was previously approved by the Kent County Remonumentation Peer Group, monumented by John A. Merdzinski on 1/29/81 and was recorded per LCRC #1765

B. Description of corner evidence found and/or method applied in restoring or reestablishing corner:


C-13 Found standard Kent Co. Mon. (Harrison) per witnesses from above LCRC as set by John A. Merdzinski in place of the 1" Iron over a 1" Iron he found. Both Irons check with Kent Co. Wit. and LCRC's #917 & #1168.

<u>LCRC #1765</u>	<u>LCRC #5809</u>
Nail & tag 24" Oak N80°W 170.37'	Nail & tag 26" Oak N83°W 170.30'
Nail & tag 24" Oak S65°W 137.92'	SE cor. brk. hse. N58°W 142.65'
Nail & tag 10" Oak S45°W 156.51'	Nail & tag P. Pole N87°E 171.23'
Nail & tag P. Pole N75°E 171.08'	KC Mon. (C-1, 6-9) West 93.69'
C/L 10" Maple N25°W 81.66'	Nail & tag 10" Oak S63°W 139.20'
NE cor. brk. plant. N35°W 178.84'	Nail & tag P. Pole S23°E 80.65'
SE cor. brk. hse. N55°W 142.65'	Nail & tag 36" Oak S84°W 190.35'

The selected location is accepted by me and is generally accepted by professional surveyors as the best available evidence of the position of the original corner.

C. Description of monument for corner and accessories established to perpetuate locating the position of the corner:

C-13 Standard Kent County Monument		
Nail & KC Remon. tag S. side 28" Oak	N83°W	170.30'
SE corner brick house #1151	N58°W	142.65'
Kent Co. Mon. (C-1, T6N, R9W)	West	93.70'
Nail & KC Remon. tag NW side 14" Oak	S63°W	139.14'
Nail & KC Remon. tag W. side P. Pole	S23°E	80.58'
Nail & KC Remon. tag SW side 36" Oak	S84°W	190.25'
C/L BT road North-South is East 1'±		
C/L BT road East is South 2'±		

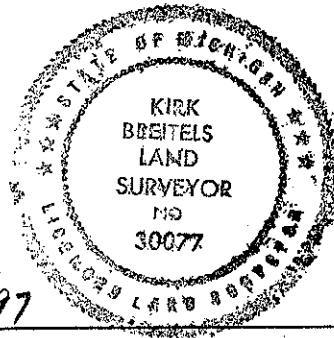

Signed by *Kirk Breitels*  
Surveyor's Michigan License No. 30077

Date 3/27/97

P.A. 345 1990 KENT COUNTY  
PEER APPROVED 3/27/97  
CHAIRMAN *Harry Hubert*