

SURVEY & REMONUMENTATION
 \$7.00
 \$2.00
 MAR 08 1999

LAND CORNER RECORDATION CERTIFICATE
Filing Requirement of Act 74, Mich. P.A. 1970
KENT COUNTY REMONUMENTATION


STATE OF MICHIGAN
 COUNTY OF KENT
 RECEIVED FOR RECORD
 38 OCT 23 AM 9:56
 REG. OF DEEDS
Luigi Bond

For corners in	SECTION	Located in:	Vergennes Township	Corner Code #
Kent (County)				
1. Public Land Survey	T <u>7N</u> R <u>9W</u>			<u>D-3</u>
	T _____ R _____			_____
	T _____ R _____			_____
	T _____ R _____			_____
2. Property Controlling in Section	S _____ T _____ R _____			_____
	S _____ T _____ R _____			_____
3. Miscellaneous Property in Sec.	S _____ T _____ R _____			_____
	S _____ T _____ R _____			_____

10749

Register of Deeds Stamp & File Number

4. Lot No. _____, Recorded Plat _____
 5. Private Claims _____

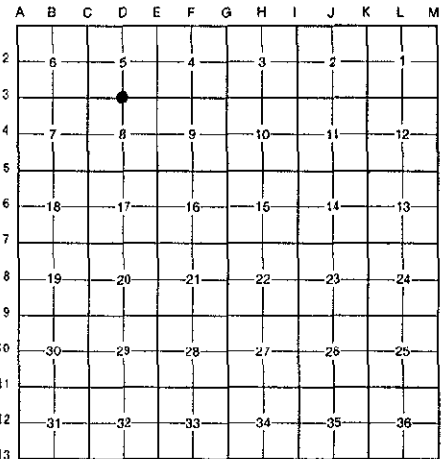

I, Randy Kolehouse, in a field survey on December 29 1997, do hereby certify that under requirements of P.A. 74 Michigan P.A. of 1970, the corner points mentioned in lines 1 and 2 above were in conformance with regulations and rules therefore as required in the current manual of survey instructions of the United States Department of the Interior, Bureau of Land Management or by a decree of a Court of Law and/or that the corner points mentioned in lines 3, 4 and 5 above were in conformance with the rules of the Michigan Board of Land Surveyors or by a Decree of a Court of Law; established, re-established, monumented, re-monumented, recovered, found as expressed below:

NOTE: Not more than 4 corners, all in the same town and range, may be recorded on this certificate.

A. Description of original monument and accessories and/or subsequent restoration:

D-3	1838	G.L.O. Notes	N. Brookfield	Set Post
	1975	L.C.R.C. #862	Medema, Van Kooten & Assoc.	"T" Iron
	1981	L.C.R.C. #1927	Jonker Land Survey	Fnd. "T" Iron / Set
	1991	L.C.R.C. #5850	Exxel Engineering	K.C. Monument

P.A. 345 1990 KENT COUNTY

PEER APPROVED 2/19/98

CHAIRMAN *[Signature]*
 K.C. Monument

This corner was originally approved by the Kent County Remonumentation Peer Group and monumented by Rob Jonker on 7/10/81 and was recorded per L.C.R.C. #1927.

B. Description of corner evidence found and/or method applied in restoring or reestablishing corner:

D-3 Found a Standard Kent County Monument on the C/L of 3 Mile Road (gravel) running East and West, on line of a fence line and tree row running North, per L.C.R.C.'s #1927 and #5850 as set by Rob Jonker in place of a "T" iron he found which checked L.C.R.C. #862.

L.C.R.C. #1927

L.C.R.C. #5850

Remon. tag on E side 10" Hickory N10°W 24.35'
 Remon. tag on E side 16" Oak S17°W 24.24'
 Remon. tag on N side 24" Hickory S62°W 45.00'
 Remon. tag on N side 12" Hickory N54°W 39.98'


Nail & remon tag in N side 24" Hickory S 63°W 45.05' (m. 44.97')
 Nail & remon tag in E side 18"W 24.21' (m. 24.24')
 Nail & remon tag in E side 12" Hickory N 11°W 24.42' (m. 24.44')
 Nail & remon tag in NE side 14" Hickory N 55°W 40.08' (m. 40.16')

The selected location is accepted by me and is generally accepted by professional surveyors as the best available evidence of the position of the original corner.

C. Description of monument for corner and accessories established to perpetuate locating the position of the corner:

D-3 Standard Kent County Monument

Nail & K.C. remon. tag on N side 24" Hickory S 63° W 44.97'
 Nail & K.C. remon. tag on E side 18" Oak S 18° W 24.24'
 Nail & K.C. remon. tag on E side 12" Hickory N 11° W 24.44'
 Nail & K.C. remon. tag on NE side 14" Hickory N 55° W 40.16'
 On C/L gravel road running E-W
 On fence line and tree row running N

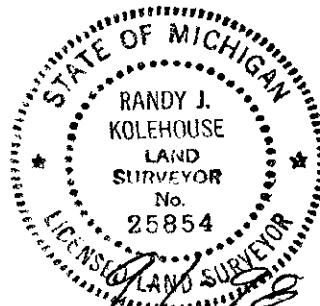

Signed by *[Signature]*
 EARTH TECH

Date _____

Surveyor's Michigan License No. 25854