

SURVEY & REMONUMENTATION

\$7.00
\$2.00

MAR 08 1999

LAND CORNER RECORDATION CERTIFICATE
Filing Requirement of Act 74, Mich. P.A. 1970
KENT COUNTY REMONUMENTATION


For corners in SECTION

Kent (County)	Located in:	Vergennes Township	Corner Code #
1. Public Land Survey	T <u>7N</u>	R <u>9W</u>	<u>D-5</u>
	T _____	R _____	_____
	T _____	R _____	_____
	T _____	R _____	_____
2. Property Controlling in Section	S _____	T _____	R _____
	S _____	T _____	R _____
3. Miscellaneous Property in Sec.	S _____	T _____	R _____
	S _____	T _____	R _____
4. Lot No. _____, Recorded Plat _____			
5. Private Claims _____			

STATE OF MICHIGAN
COUNTY OF KENT
RECEIVED FOR RECORD
38 OCT 23 AM 9:56
REG. OF DEEDS
Lucy St. Paul

10750

Register of Deeds Stamp & File Number

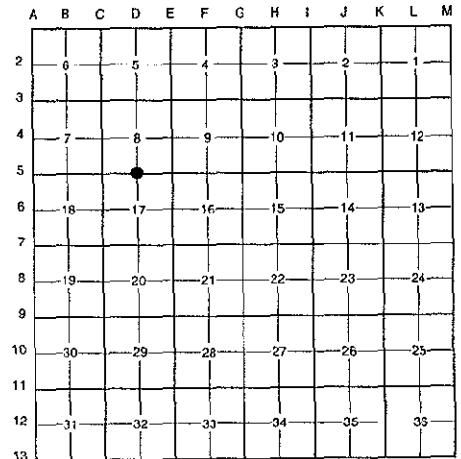

I, Randy Kolehouse, in a field survey on December 26 19 97, do hereby certify that under requirements of P.A. 74 Michigan P.A. of 1970, the corner points mentioned in lines 1 and 2 above were in conformance with regulations and rules therefore as required in the current manual of survey instructions of the United States Department of the interior, Bureau of Land Management or by a decree of a Court of Law and/or that the corner points mentioned in lines 3, 4 and 5 above were in conformance with the rules of the Michigan Board of Land Surveyors or by a Decree of a Court of Law; established, re-established, monumented, re-monumented, recovered, found as expressed below:

NOTE: Not more than 4 corners, all in the same town and range, may be recorded on this certificate.

A. Description of original monument and accessories and/or subsequent restoration:

D-5	1838	G.L.O. Notes	N. Brookfield	Set Post	P.A. 345 1990 KENT COUNTY PEER APPROVED <u>2/19/98</u> CHAIRMAN <u>Randy Kolehouse</u> K.C. Monument in a Mon. Box
	1965	Witness Map	K.C. Surveyor	1" Iron	
	1973	L.C.R.C. #3267	C. Hay	Re-rod & Cap	
	1983	L.C.R.C. #3453	Williams & Works	Fnd. Capped Rerod in Mon. Box	
	1991	L.C.R.C. #5851	Exxel Engineering	K.C. Monument in a Mon. Box	

This corner was originally approved by the Kent County Remonumentation Peer Group and monumented by Williams & Works on 7/7/83 and was recorded per L.C.R.C. #3453.

B. Description of corner evidence found and/or method applied in restoring or reestablishing corner:

D-5 Found a Standard Kent County Monument in a monument box on the C/L of 2 Mile Road (bit.) running East and West, on line of a tree row running North and occupation line running South, per L.C.R.C.'s #3453 and #5851 as set by Williams & Works in place of a capped rerod they found in a monument box which checked L.C.R.C. #3267 and the K.C. Surveyor's records.

L.C.R.C. #3453

L.C.R.C. #5851

SE corner house foundation N.60°W. 190.30'
Nail & KC.Remon.tag in S.side 36" Maple N.75°W. 168.37'
Nail & KC.Remon.tag in E.side twin 5" W.Cherry N.05°E. 43.21'
"X" cut on east end concrete drive culvert N.45°W. 36.90'

SE cor hse fndn. N 67°W 1990.30' (m. 190.25')
"X" in E end conc. culv. N 50°W 36.90' (m. 36.92')
Nail & remon tag in E side 7" twin W. Cherry N 6°E 43.16' (m. 43.24')
Nail & remon tag in N side 38" Maple S 79°W 220.67' (m. 220.60')

The selected location is accepted by me and is generally accepted by professional surveyors as the best available evidence of the position of the original corner.

C. Description of monument for corner and accessories established to perpetuate locating the position of the corner:

D-5 Standard Kent County Monument in a Monument Box

SE cor. hse. fndn. hse #10769 N 57° W 190.25'
"X" cut in top E end conc. culvert N 50° W 36.92'
Nail & K.C. remon. tag on E side 8" Twin White Cherry N 06° E 43.24'
Nail & K.C. remon. tag on N side 38" Maple S 79° W 220.60'
Nail & K.C. remon. tag on S side 36" Maple N 75° W 168.30'
C/L bit. road running E-W
On tree row running N
On occupation line running S



Signed by Randy J. Kolehouse Date _____

EARTH TECH

Surveyor's Michigan License No. 25854