

\$7.00  
\$2.00

MAR 08 1999

LAND CORNER RECORDATION CERTIFICATE  
Filing Requirement of Act 74, Mich. P.A. 1970  
KENT COUNTY REMONUMENTATION

SECTION

For corners in

Kent (County)	Located in: Vergennes Township	Corner Code #
1. Public Land Survey	T <u>7N</u> R <u>9W</u>	<u>D-7</u>
	T _____ R _____	_____
	T _____ R _____	_____
	T _____ R _____	_____
2. Property Controlling in Section	S _____ T _____ R _____	_____
	S _____ T _____ R _____	_____
3. Miscellaneous Property in Sec.	S _____ T _____ R _____	_____
	S _____ T _____ R _____	_____

REG. OF DEEDS

*W. J. K.*

38 OCT 23 AM 9:56

STATE OF MICHIGAN  
COUNTY OF KENT  
RECEIVED FOR RECORD

10751

Register of Deeds Stamp & File Number

4. Lot No. \_\_\_\_\_, Recorded Plat \_\_\_\_\_  
5. Private Claims \_\_\_\_\_


I, Randy Kolehouse, in a field survey on December 30 19 97, do hereby certify that under requirements of P.A. 74 Michigan P.A. of 1970, the corner points mentioned in lines 1 and 2 above were in conformance with regulations and rules therefore as required in the current manual of survey instructions of the United States Department of the interior, Bureau of Land Management or by a decree of a Court of Law and/or that the corner points mentioned in lines 3, 4 and 5 above were in conformance with the rules of the Michigan Board of Land Surveyors or by a Decree of a Court of Law; established, re-established, monumented, re-monumented, recovered, found as expressed below:

NOTE: Not more than 4 corners, all in the same town and range, may be recorded on this certificate.

A. Description of original monument and accessories and/or subsequent restoration:

D-7	1838	G.L.O. Notes	N. Brookfield	Set Post
	N/A	Witness Map	K.C. Surveyor	Leaded Stone
	1973	L.C.R.C. #515	Exxel Engineering	Set 1" Iron
	1974	L.C.R.C. #737	J. Clapp	Iron Pipe
	1981	L.C.R.C. #1735	Williams & Works	Fnd. 1" Iron Pipe / Set K.C. Monument
	1991	L.C.R.C. #5852	Exxel Engineering	K.C. Monument

P.A. 345 1990 KENT COUNTY  
PEER APPROVED 2/19/99  
CHAIRMAN [Signature]

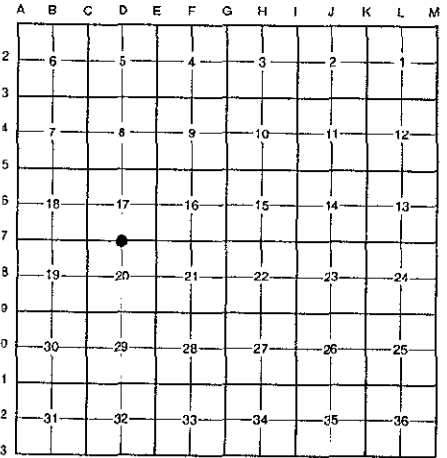

This corner was originally approved by the Kent County Remonumentation Peer Group and monumented by Williams & Works on 1/2/81 and was recorded per L.C.R.C. #1735.

B. Description of corner evidence found and/or method applied in restoring or reestablishing corner:

D-7 Found a Standard Kent County Monument 3' North of the C/L of McPherson Street (gravel) running East and West, on line of old fence line running North, per L.C.R.C.'s #1735 and #5852 as set by Williams & Works in place of a 1" iron pipe they found with a 1/2" pipe inside which checked L.C.R.C.'s #737 and #515.

L.C.R.C. #1735

L.C.R.C. #5852

- Nail & K.C. Remon. Tag in NW Side 10" Maple S 50°W 64.30'
- Nail & K.C. Remon. Tag in SW Side 28" Oak S 45°E 45.89'
- Nail & K.C. Remon. Tag in W Side 8" Twin Maple S 10°W 64.63'
- Nail & K.C. Remon. Tag in W Side 40" Oak N 10°E 14.59'
- Nail & K.C. Remon. Tag in SW Side 12" Maple N 40°W 45.03'
- Nail & K.C. Remon. Tag in S Side 8" Oak N 65°E 60.19'


- Nail & KC remon tag in NW side 14" Maple S 53°W 64.38' (m. 64.40)
- Nail & remon tag in SW side 20" Maple S 43°E 45.95' (m. 45.98')
- Nail & KC remon tag in W side 12" Twin Maple S 09°W 64.78' (m. 64.80)
- Nail & remon tag in W side 40" Oak N 07°W 14.48' (m. 14.44')
- Nail & remon tag in SW side 18" Maple N 43°W 45.05' (m. 45.04')
- Nail & remon tag in S side 10" Oak N 66° E 60.15' (m. 60.09')

The selected location is accepted by me and is generally accepted by professional surveyors as the best available evidence of the position of the original corner.

C. Description of monument for corner and accessories established to perpetuate locating the position of the corner:

D-7 Standard Kent County Monument

- Nail & K.C. remon. tag on NW side 14" Maple S 53° W 64.40'
- Nail & K.C. remon. tag on SW side 20" Maple S 43° E 45.98'
- Nail & K.C. remon. tag on W side 12" Twin Maple S 09° W 64.80'
- Nail & K.C. remon. tag on W side 40" Oak N 07° W 14.44'
- Nail & K.C. remon. tag on SW side 18" Maple N 43° W 45.05'
- Nail & K.C. remon. tag on S side 10" Oak N 66° E 60.09'
- C/L gravel road running E-W, South 3.0'
- On old fence line running N

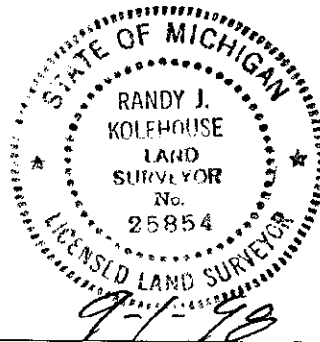

Signed by [Signature] Date 9-1-98

Surveyor's Michigan License No. 25854