

SURVEY & REMONUMENTATION

\$7.00
\$2.00

MAR 08 1999

LAND CORNER RECORDATION CERTIFICATE
Filing Requirement of Act 74, Mich. P.A. 1970
KENT COUNTY REMONUMENTATION

SECTION

STATE OF MICHIGAN
COUNTY OF KENT
RECEIVED FOR RECORD
38 OCT 23 AM 9:56

REG. OF DEEDS
Tim Standa

10752

Register of Deeds Stamp & File Number


For corners in

Kent
(County)

Located in: Vergennes Township Corner Code #

1. Public Land Survey	T <u>7N</u> R <u>9W</u>	D-9
	T _____ R _____	_____
	T _____ R _____	_____
	T _____ R _____	_____
2. Property Controlling in Section	S _____ T _____ R _____	_____
	S _____ T _____ R _____	_____
3. Miscellaneous Property in Sec.	S _____ T _____ R _____	_____
	S _____ T _____ R _____	_____

4. Lot No. _____, Recorded Plat _____
5. Private Claims _____

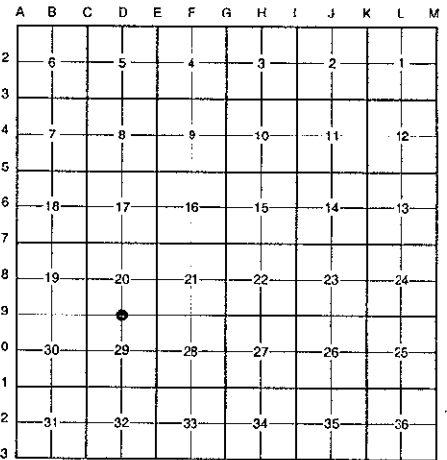

I, Randy Kolehouse, in a field survey on January 6 19 98, do hereby certify that under requirements of P.A. 74 Michigan P.A. of 1970, the corner points mentioned in lines 1 and 2 above were in conformance with regulations and rules therefore as required in the current manual of survey instructions of the United States Department of the interior, Bureau of Land Management or by a decree of a Court of Law and/or that the corner points mentioned in lines 3, 4 and 5 above were in conformance with the rules of the Michigan Board of Land Surveyors or by a Decree of a Court of Law; established, re-established, monumented, re-monumented, recovered, found as expressed below:

NOTE: Not more than 4 corners, all in the same town and range, may be recorded on this certificate.

A. Description of original monument and accessories and/or subsequent restoration:

D-9	1838	G.L.O. Notes	N. Brookfield	Set Post
	1958	Witness Map	K.C. Surveyor	3" Iron
	1973	L.C.R.C. #515	Exxel Engineering	Bt. Spike Over Iron
	1974	L.C.R.C. #737	J. Clapp	Boat Spike
	1981	L.C.R.C. #1928	Jonker Land Survey	Fnd. Boat Spike / Set K.C. Monument
	1991	L.C.R.C. #5853	Exxel Engineering	K.C. Monument

P.A. 345 1990 KENT COUNTY
PEER APPROVED 2/19/98
CHAIRMAN Randy Kolehouse

This corner was originally approved by the Kent County Remonumentation Peer Group and monumented by Rob Jonker on 7/9/81 and was recorded per L.C.R.C. #1928.

B. Description of corner evidence found and/or method applied in restoring or reestablishing corner:

D-9 Found a Standard Kent County Monument 2' North of the C/L of Bailey Drive (bit.) running East and West, on line of a tree row running South, and 3' West of a fence line running North per L.C.R.C.'s #1928 and #5853 as set by Rob Jonker in place of a boat spike he found over a 3/4" iron 6" below grade over a 2"x29" round pipe 12" below grade which checked L.C.R.C.'s #737, #515 and the K.C. Surveyor's records.

L.C.R.C. #1928

L.C.R.C. #5853


Remon. tag on SE side E. gate post N59°E 58.02'	Nail & remon tag in E side P.Pole S 10°W 127.28' (m. 127.30')
Remon. tag on E side p.pole N1°E 102.98'	PK nail in top of headwall over culvert S 74°W 66.18'
C/L W. end dr. culv. S11°E 21.66'	Nail & remon tag in E side P.Pole N 01°E 102.97' (m. 103.00')
	Nail & remon tag in SE side gate post N 60°E 58.10' (m. 58.32')

The selected location is accepted by me and is generally accepted by professional surveyors as the best available evidence of the position of the original corner.

C. Description of monument for corner and accessories established to perpetuate locating the position of the corner:

D-9 Standard Kent County Monument

- Nail & K.C. remon. tag on E side P. pole S 10° W 127.30'
- Nail & K.C. remon. tag on top of conc. headwall over culvert S 74° W 66.18'
- Nail & K.C. remon. tag on E side P. pole N 01° E 103.00'
- Nail & K.C. remon. tag on SE side gate post N 60° E 58.32'
- C/L W end culvert S 11° E 21.53'
- C/L bit. road E-W, South 2.0'
- Fence line running N, East 3.0'
- On tree row running S

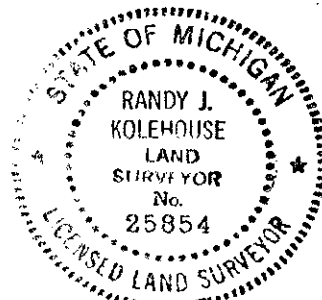

Signed by Randy J. Kolehouse Date 9-1-98

EARTH TECH

Surveyor's Michigan License No. 25854