

\$7.00
\$2.00

MAR 08 1999

SECTION

LAND CORNER RECORDATION CERTIFICATE
Filing Requirement of Act 74, Mich. P.A. 1970
KENT COUNTY REMONUMENTATION

For corners in

Kent (County)	Located in: Vergennes Township	Corner Code #
1. Public Land Survey	T <u>7N</u> R <u>9W</u>	<u>D-10</u>
	T _____ R _____	_____
	T _____ R _____	_____
	T _____ R _____	_____
2. Property Controlling in Section	S _____ T _____ R _____	_____
	S _____ T _____ R _____	_____
3. Miscellaneous Property in Sec.	S _____ T _____ R _____	_____
	S _____ T _____ R _____	_____
4. Lot No. _____, Recorded Plat _____		
5. Private Claims _____		

REG. OF DEEDS

Handwritten signature

98 DEC 14 AM 8:00

STATE OF MICHIGAN
COUNTY OF KENT
RECEIVED FOR RECORD

11022

Register of Deeds Stamp & File Number

I, Randy Kolehouse, in a field survey on December 2 19 98, do hereby certify that under requirements of P.A. 74 Michigan P.A. of 1970, the corner points mentioned in lines 1 and 2 above were in conformance with regulations and rules therefore as required in the current manual of survey instructions of the United States Department of the interior, Bureau of Land Management or by a decree of a Court of Law and/or that the corner points mentioned in lines 3, 4 and 5 above were in conformance with the rules of the Michigan Board of Land Surveyors or by a Decree of a Court of Law; established, re-established, monumented, re-monumented, recovered, found as expressed below:

NOTE: Not more than 4 corners, all in the same town and range, may be recorded on this certificate.

A. Description of original monument and accessories and/or subsequent restoration:

D-10 This corner was not originally set by the G.L.O.

N/A	Witness Map	K.C. Surveyor	Leaded Stone
1985	Survey Records	Williams & Works	Held Intersection of 1/4 Lines / No Corner Set

P.A. 345 1990 KENT COUNTY
PEER APPROVED 8/20/98
CHAIRMAN *Handwritten signature*

B. Description of corner evidence found and/or method applied in restoring or reestablishing corner:


D-10 Nothing found at this corner. Set a monument at the intersection of 1/4 lines. Monument is on line of a tree row and fence line running North, South and West and 15' North of a fence line running East.

The selected location is accepted by me and is generally accepted by professional surveyors as the best available evidence of the position of the original corner.

C. Description of monument for corner and accessories established to perpetuate locating the position of the corner:

D-10 Set a Standard Kent County Monument

- Nail & K.C. remon. tag on W side 10" Maple S 06° W 2.41'
- Nail & K.C. remon. tag on N side 10" Maple S 66° W 5.49'
- Nail & K.C. remon. tag on W side 8" Maple N 32° W 13.54'
- Nail & K.C. remon. tag on W side 16" Maple N 12° E 19.54'
- On line of a tree row and fence line running N-S & W
- Fence line running E, South 15'

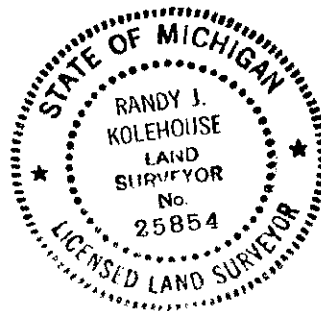

Signed by Randy J. Kolehouse
EARTH TECH

Date 12-4-98

Surveyor's Michigan License No. 25854

