

MAR 08 1999

\$7.00
\$2.00

LAND CORNER RECORDATION CERTIFICATE
Filing Requirement of Act 74, Mich. P.A. 1970
KENT COUNTY REMONUMENTATION

STATE OF MICHIGAN
COUNTY OF KENT
RECEIVED FOR RECORD
38 OCT 23 AM 9:56
REG. OF DEEDS
David Sand

SECTION

For corners in


Kent (County)	Located in: Vergennes Township	Corner Code #
1. Public Land Survey	T <u>7N</u> R <u>9W</u>	<u>D-11</u>
	T _____ R _____	_____
	T _____ R _____	_____
	T _____ R _____	_____
2. Property Controlling in Section	S _____ T _____ R _____	_____
	S _____ T _____ R _____	_____
3. Miscellaneous Property in Sec.	S _____ T _____ R _____	_____
	S _____ T _____ R _____	_____

10753

Register of Deeds Stamp & File Number

4. Lot No. _____, Recorded Plat _____
5. Private Claims _____

I, Randy Kolehouse, in a field survey on January 5 19 98, do hereby certify that under requirements of P.A. 74 Michigan P.A. of 1970, the corner points mentioned in lines 1 and 2 above were in conformance with regulations and rules therefore as required in the current manual of survey instructions of the United States Department of the interior, Bureau of Land Management or by a decree of a Court of Law and/or that the corner points mentioned in lines 3, 4 and 5 above were in conformance with the rules of the Michigan Board of Land Surveyors or by a Decree of a Court of Law; established, re-established, monumented, re-monumented, recovered, found as expressed below:

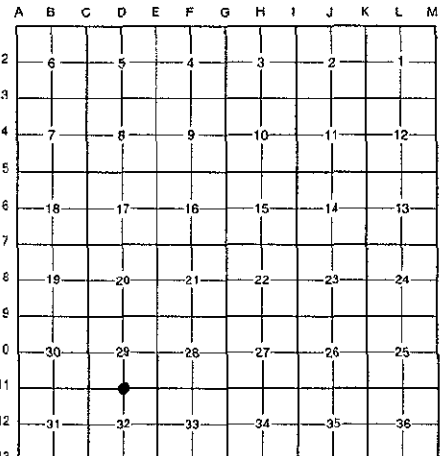

NOTE: Not more than 4 corners, all in the same town and range, may be recorded on this certificate.

A. Description of original monument and accessories and/or subsequent restoration:

D-11 1838	G.L.O. Notes	N. Brookfield	Set Post
1879	Notes	Williams & Works	Leaded Stone
1961	Witness Map	K.C. Surveyor	Iron Pipe / Leaded Stone
1983	L.C.R.C. #3544	T. Chettleburgh	Fnd. "T" Iron / Set K.C. Monument
1991	L.C.R.C. #5854	Exxel Engineering	K.C. Monument

P.A. 345 1990 KENT COUNTY
PEER APPROVED 2/19/99
CHAIRMAN Randy Kolehouse

This corner was originally approved by the Kent County Remonumentation Peer Group and monumented by T. Chettleburgh on 8/5/83 and was recorded per L.C.R.C. #3544.

B. Description of corner evidence found and/or method applied in restoring or reestablishing corner:

D-11 Found a Standard Kent County Monument on the C/L of Vergennes Street (bit.) running East and West, on line of a tree row and fence line running North and South, per L.C.R.C.'s #3544 and #5854 as set by T. Chettleburgh in place of a "T" iron he found above an iron pipe and pointed leaded stone which checked the 1879 notes of Williams & Works and the K.C. Surveyor's records.

L.C.R.C. #3544

L.C.R.C. #5854

Nail in W side 32" Oak North 35.08'
Nail in SW side 37" Oak SE 59.65'


Mon. on line with fences & tree rows to N & S
Nail & remon tag in W side 32" Oak North 35.10' (m. 35.14')
Nail & remon tag in SW side 40' Oak S 51°E 59.68' (m. 59.65')
Nail & remon tag in S side 12" Hickory N 82°E 111.00' (m. 111.05')

The selected location is accepted by me and is generally accepted by professional surveyors as the best available evidence of the position of the original corner.

C. Description of monument for corner and accessories established to perpetuate locating the position of the corner:

D-11 Standard Kent County Monument

- Nail & K.C. remon. tag on W side 32" Oak North 35.14'
- Nail & K.C. remon. tag on SW side 40" Oak S 51° E 59.65'
- Nail & K.C. remon. tag on S side 12" Hickory N 82° E 111.05'
- Nail & K.C. remon. tag on E side 12" Maple S 10° E 33.45'
- On C/L bit. road running E-W
- On tree row and fence line running N-S

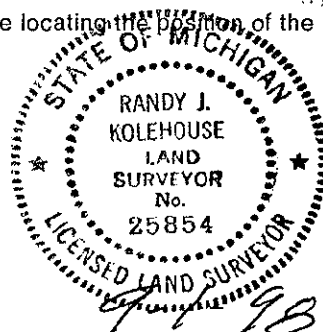

Signed by Randy J. Kolehouse Date _____

EARTH TECH

Surveyor's Michigan License No. 25854