

**SURVEY & REMONUMENTATION**

**MAR 03 1998**

**KENT COUNTY REMONUMENTATION**

**SECTION**

**LAND CORNER RECORDATION CERTIFICATE**  
Filing Requirement of Act 74, Mich. P.A. 1970

For corners in

KENT COUNTY

(County)

Located In:

Corner Code #

1. Public Land Survey	T <u>7</u> N	R <u>9</u> W	D-13
	T	R	
	T	R	
	T	R	
2. Property Controlling in Section	S	T	R
	S	T	R
3. Miscellaneous Property in Sec.	S	T	R
	S	T	R

STATE OF MICHIGAN  
 COUNTY OF KENT  
 RECEIVED FOR RECORD  
 97 JUN -3 AM 8:11  
 REG. OF DEEDS  
*Lucy St. John*

**9999**

Register of Deeds Stamp & File Number

4. Lot No. \_\_\_\_\_, Recorded Plat \_\_\_\_\_  
 5. Private Claims \_\_\_\_\_

I, Kirk Breitels, in a field survey on May 13, 1997 do hereby state that under requirements of P.A. 74, Michigan P.A. of 1970, the corner points mentioned in lines 1 and 2 above were in conformance with regulations and rules therefore as required in the current manual of survey instructions of the United States Department of the Interior, Bureau of Land Management or by a decree of a Court of Law and /or that the corner points mentioned in lines 3, 4 and 5 above were in conformance with the rules of the Michigan Board of Land Surveyors or by a Decree of a Court of Law; established, re-established, monumented, recovered, found as expressed below:

NOTE: Not more than 2 corners, all in the same town and range, may be recorded on this certificate.

	A	B	C	D	E	F	G	H	I	J	K	L	M
1													
2	6		5		4		3		2		1		
3													
4	7		8		9		10		11		12		
5													
6	16		17		16		15		14		13		
7													
8	19		20		21		22		23		24		
9													
10	30		29		28		27		26		25		
11													
12	31		32		33		34		35		36		
13													

A. Description of original monument and accessories and/or subsequent restoration:

D-13	1830	GLO	Mullett	Set Post
	1971	Kent Co. Wit.		Leaded Stone
	1978	LCRC #1169	Merdzinski	Leaded Stone
	1981	LCRC #1762	Merdzinski	Set Kent County Monument
	1991	LCRC #5855	Unema	Kent County Monument

The position of this corner was previously approved by the Kent County Remonumentation Peer Group, monumented by John A. Merdzinski on 1/29/81 and was recorded per LCRC #1762

B. Description of corner evidence found and/or method applied in restoring or reestablishing corner:


D-13 Found BROKEN standard Kent Co. Mon. (Harrison) per witnesses from above LCRC as set by John A. Merdzinski in place of the Large Stone he found. Said Stone checks with Kent Co. Wits. and LCRC #1169. Removed and reset standard Kent Co. Mon. per witnesses.

<u>LCRC #1762</u>	<u>LCRC #5855</u>
Nail & tag 12" Tw. Cherry S50°E 49.81'	Nail & tag Twin 16" Oak N07°E 47.04'
Nail & tag 12" Oak S10°E 38.12'	Nail & tag 12" Oak N53°E 57.41'
Nail & tag 10" Oak S50°W 20.68'	Nail & tag 14" Cherry S48°E 49.65'
Nail & tag 8" Oak N55°E 21.21'	Nail & tag 14" Oak S36°W 52.47'
Nail & tag 12" Oak N80°E 44.34'	KC. Mon. (D-1, 6-9) West 75.77'
Nail & tag 14" Twin Oak N10°E 47.00'	

The selected location is accepted by me and is generally accepted by professional surveyors as the best available evidence of the position of the original corner.

C. Description of monument for corner and accessories established to perpetuate locating the position of the corner:

D-13. Standard Kent County Monument			
Nail & KC Remon. tag W. side Tw. 18" Oak	N07°E	47.04'	
Nail & KC Remon. tag NW side 14" Oak	N53°E	57.41'	
Nail & KC Remon. tag NE side 16" Cherry	S48°E	49.65'	
Nail & KC Remon. tag W. side 16" Oak	S36°W	52.49'	
Kent Co. Mon. (D-1, T6N, R9W)	West	75.77'	
"T" Iron - North		33.00'	
On approx. C/L E-W asphalt road			

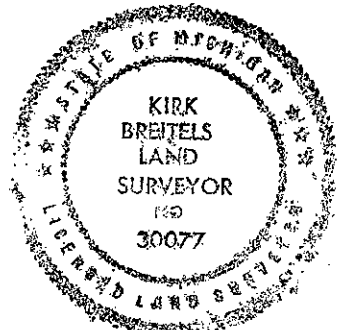

Signed by *Kirk Breitels*  
 Surveyor's Michigan License No. 30077

Date 5/22/97

P.A. 345 1990 KENT COUNTY

PEER APPROVED 5/22/97  
 CHAIRMAN *Ferry Kuper*