

\$7.00
\$2.00

MAR 08 1999

LAND CORNER RECORDATION CERTIFICATE
Filing Requirement of Act 74, Mich. P.A. 1970
KENT COUNTY REMONUMENTATION

STATE OF MICHIGAN
COUNTY OF KENT
RECEIVED FOR RECORD
38 OCT 23 AM 9:55
REG. OF DEEDS
Lucy Bond

SECTION


For corners in	Located in:	Corner Code #
Kent (County)	Vergennes Township	
1. Public Land Survey	T <u>7N</u> R <u>9W</u>	<u>E-1</u>
	T _____ R _____	_____
	T _____ R _____	_____
	T _____ R _____	_____
2. Property Controlling in Section	S _____ T _____ R _____	_____
	S _____ T _____ R _____	_____
3. Miscellaneous Property in Sec.	S _____ T _____ R _____	_____
	S _____ T _____ R _____	_____
4. Lot No. _____, Recorded Plat _____		
5. Private Claims _____		

10754

Register of Deeds Stamp & File Number

I, Randy Kolehouse, in a field survey on December 26 19 97, do hereby certify that under requirements of P.A. 74 Michigan P.A. of 1970, the corner points mentioned in lines 1 and 2 above were in conformance with regulations and rules therefore as required in the current manual of survey instructions of the United States Department of the interior, Bureau of Land Management or by a decree of a Court of Law and/or that the corner points mentioned in lines 3, 4 and 5 above were in conformance with the rules of the Michigan Board of Land Surveyors or by a Decree of a Court of Law; established, re-established, monumented, re-monumented, recovered, found as expressed below:

NOTE: Not more than 4 corners, all in the same town and range, may be recorded on this certificate.

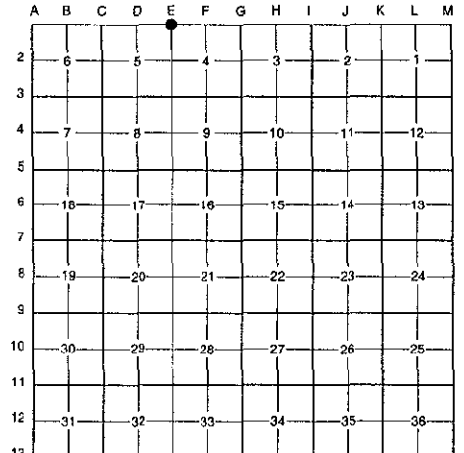

A. Description of original monument and accessories and/or subsequent restoration:

E-1	1837	G.L.O. Notes	N. Brookfield	Set Post
	N/A	Witness Map	K.C. Surveyor	Concrete Monument
	1975	L.C.R.C. #862	Medema, Van Kooten & Assoc.	Concrete Monument
	1986	L.C.R.C. #4356	R. Kolehouse	Fnd. Concrete Mon. / Set K.C. Monument
	1994	L.C.R.C. #8009	Glaza & Associates	K.C. Monument

P.A. 345 1990 KENT COUNTY
PEER APPROVED 12/19/98
CHAIRMAN *Randy Kolehouse*

Note: This corner is not common with E-13, T8N, R9W.

This corner was originally approved by the Kent County Remonumentation Peer Group and monumented by Randy Kolehouse on 11/16/85 and was recorded per L.C.R.C. #4356.

B. Description of corner evidence found and/or method applied in restoring or reestablishing corner:

E-1 Found a Standard Kent County Monument 61.5' East of the C/L of Murray Lake Road (bit.) running North and South and 10' North of the C/L of 4 Mile Road (gravel) running West per L.C.R.C.'s #4356 and #8009 as set by Randy Kolehouse in place of a concrete monument he found which checked L.C.R.C. #862 and the K.C. Surveyor's records.

L.C.R.C. #4356

L.C.R.C. #8009

Nail & K.C. Remon. tag in W. side 50" Oak N 30° E 25.06'
Nail & K.C. Remon. tag in SE side P. Pole S 35° W 39.05'
K.C. Monument at the SW cor. section 33 T8N R9W West 73.90'

Nail & K.C. remon tag in W side 50" Oak N30°E 25.11' (m. 25.03')
Nail & K.C. remon tag in SE side P. pole S35°W 38.99'
K.C. mon. at the SW cor. of. Sec. 33, T8N, R9W West 73.84'
Nail & K.C. remon tag in W side 6" Tree N40°W 4.03'
In fence line to the East N40°W 4.03'

The selected location is accepted by me and is generally accepted by professional surveyors as the best available evidence of the position of the original corner.

C. Description of monument for corner and accessories established to perpetuate locating the position of the corner:

E-1 Standard Kent County Monument

- Nail & K.C. remon. tag on W side 50" Oak N 30° E 25.03'
- Nail & K.C. remon. tag on SE side P. pole 4' above gmd. S 35° W 38.99'
- Nail & K.C. remon. tag on W side 6" Maple N 40° W 4.03'
- Nail & K.C. remon. tag on N side 6" Oak S 40° E 7.68'
- Nail & K.C. remon. tag on NW side 50" Oak N 30° E 26.50' (2 nails)
- On C/L bit. road running N-S
- C/L gravel road running W, South 10.0'
- K.C. Mon., E-13, T8N, R9W, 73.84'



Signed by *Randy J. Kolehouse*
EARTH TECH

Date 9-1-98

Surveyor's Michigan License No. 25854