

MAR 08 1999

LAND CORNER RECORDATION CERTIFICATE  
Filing Requirement of Act 74, Mich. P.A. 1970  
KENT COUNTY REMONUMENTATION

STATE OF MICHIGAN  
COUNTY OF KENT  
RECEIVED FOR RECORD  
38 OCT 23 AM 9:56  
REG. OF DEEDS  
*Lucy Bond*

\$7.00  
\$2.00


SECTION

For corners in

Kent (County)	Located in: Vergennes Township	Corner Code #
1. Public Land Survey	T <u>7N</u> R <u>9W</u>	<u>E-2</u>
	T _____ R _____	_____
	T _____ R _____	_____
	T _____ R _____	_____
2. Property Controlling in Section	S _____ T _____ R _____	_____
	S _____ T _____ R _____	_____
3. Miscellaneous Property in Sec.	S _____ T _____ R _____	_____
	S _____ T _____ R _____	_____
4. Lot No. _____, Recorded Plat _____		
5. Private Claims _____		

10755

Register of Deeds Stamp & File Number

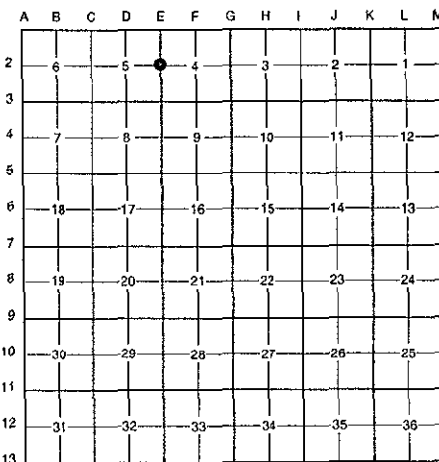

I, Randy Kolehouse, in a field survey on December 27 19 97, do hereby certify that under requirements of P.A. 74 Michigan P.A. of 1970, the corner points mentioned in lines 1 and 2 above were in conformance with regulations and rules therefore as required in the current manual of survey instructions of the United States Department of the interior, Bureau of Land Management or by a decree of a Court of Law and/or that the corner points mentioned in lines 3, 4 and 5 above were in conformance with the rules of the Michigan Board of Land Surveyors or by a Decree of a Court of Law; established, re-established, monumented, re-monumented, recovered, found as expressed below:

NOTE: Not more than 4 corners, all in the same town and range, may be recorded on this certificate.

A. Description of original monument and accessories and/or subsequent restoration:

E-2	1838	G.L.O. Notes	N. Brookfield	Set Post
	1964-66	Witness Map	K.C. Surveyor	Concrete Monument
	1975	L.C.R.C. #861	Medema, Van Kooten & Assoc.	1" Iron
	1981	L.C.R.C. #1929	Jonker Land Survey	Fnd. 1" Iron / Set K.C. Monument
	1991	L.C.R.C. #5837	Exxel Engineering	K.C. Monument

P.A. 345 1990 KENT COUNTY  
PEER APPROVED 2/19/98  
CHAIRMAN Randy Kolehouse

This corner was originally approved by the Kent County Remonumentation Peer Group and monumented by Rob Jonker on 7/10/81 and was recorded per L.C.R.C. #1929.

B. Description of corner evidence found and/or method applied in restoring or reestablishing corner:


E-2 Found a Standard Kent County Monument 2.0' East of the C/L intersection of Murray Lake Road (bit.) running North and South and Lalley Road (bit.) running East per L.C.R.C.'s #1929 and #5837 as set by Rob Jonker in place of a 1" solid iron he found at grade over a plat monument 1.0' below grade which checked L.C.R.C. #861 and the K.C. Surveyor's records.

L.C.R.C. #1929	L.C.R.C. #5837
Remon. tag on SE side p.pole N40°E 78.92'	Nail & remon tag in N side 15" Ash N 75°W 52.06' (m. 52.03')
Remon. tag on N side 15" Ash N75°W 52.07'	Nail & remon tag in SE side 10" Maple S 55°W 88.20' (m. 88.18')
Remon. tag on N side P. pole S78°E 155.45'	Nail & remon tag in SE side P.Pole N 40°E 78.90' (m. 78.93')
"X" on top curb S43°E 35.74'	Nail & remon tag in N side P.Pole S 76°E 155.45' (m. 155.53')
C/L "X" of B.T. is E. 2'	"X" on top of curb S 42°E 35.74'
	C/L "X" of BT is W 2'

The selected location is accepted by me and is generally accepted by professional surveyors as the best available evidence of the position of the original corner.

C. Description of monument for corner and accessories established to perpetuate locating the position of the corner:

E-2 Standard Kent County Monument  
Nail & K.C. remon. tag on N side 15" Ash N 75° W 52.03'  
Nail & K.C. remon. tag on SE side 10" Maple S 55° W 88.18'  
Nail & K.C. remon. tag on SE side P. pole N 40° E 78.93'  
Nail & K.C. remon. tag on N side P. pole S 76° E 155.53'  
"X" cut on top of curb S 42° E 35.74'  
C/L "X" bit. roads running N-S-E, West 2.0'

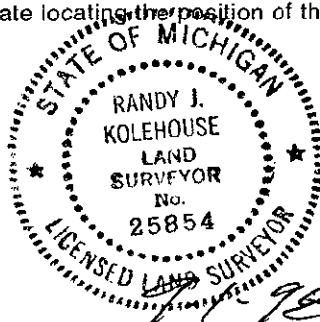

Signed by Randy J Kolehouse Date \_\_\_\_\_

Surveyor's Michigan License No. 25854