

MAR 08 1999

\$7.00  
\$2.00

SECTION

LAND CORNER RECORDATION CERTIFICATE  
Filing Requirement of Act 74, Mich. P.A. 1970  
KENT COUNTY REMONUMENTATION

For corners in

Kent (County)	Located in: Vergennes Township	Corner Code #
1. Public Land Survey	T <u>7N</u> R <u>9W</u>	<u>E-3</u>
	T _____ R _____	_____
	T _____ R _____	_____
	T _____ R _____	_____
2. Property Controlling in Section	S _____ T _____ R _____	_____
	S _____ T _____ R _____	_____
3. Miscellaneous Property in Sec.	S _____ T _____ R _____	_____
	S _____ T _____ R _____	_____


STATE OF MICHIGAN  
COUNTY OF KENT  
RECEIVED FOR RECORD  
98 OCT 23 AM 9:55  
REG. OF DEEDS  
*W. J. Koblehouse*

10756

Register of Deeds Stamp & File Number

4. Lot No. \_\_\_\_\_, Recorded Plat \_\_\_\_\_  
5. Private Claims \_\_\_\_\_

I, Randy Koblehouse, in a field survey on December 27 19 97, do hereby certify that under requirements of P.A. 74 Michigan P.A. of 1970, the corner points mentioned in lines 1 and 2 above were in conformance with regulations and rules therefore as required in the current manual of survey instructions of the United States Department of the interior, Bureau of Land Management or by a decree of a Court of Law and/or that the corner points mentioned in lines 3, 4 and 5 above were in conformance with the rules of the Michigan Board of Land Surveyors or by a Decree of a Court of Law; established, re-established, monumented, re-monumented, recovered, found as expressed below:

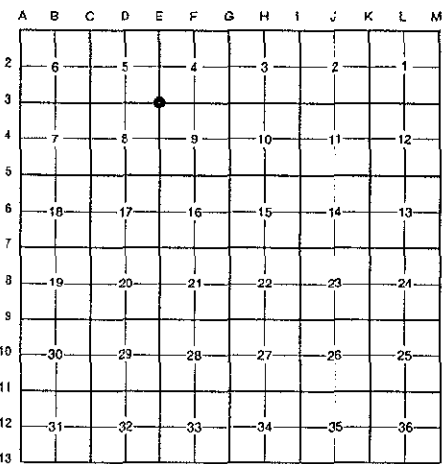

NOTE: Not more than 4 corners, all in the same town and range, may be recorded on this certificate.

A. Description of original monument and accessories and/or subsequent restoration:

E-3	1838	G.L.O. Notes	N. Brookfield	Set Post
	N/A	Witness Map	K.C. Surveyor	Boat Spike
	1978	L.C.R.C. #1204	Nederveld & Jonker	"T" Iron
	1981	L.C.R.C. #1930	Jonker Land Survey	Fnd. "T" Iron / Set K.C. Monument
	1991	L.C.R.C. #5838	Exxel Engineering	K.C. Monument

P.A. 345 1990 KENT COUNTY  
PEER APPROVED 2/19/98  
CHAIRMAN Hans Huber


This corner was originally approved by the Kent County Remonumentation Peer Group and monumented by Rob Jonker on 7/10/81 and was recorded per L.C.R.C. #1930.

B. Description of corner evidence found and/or method applied in restoring or reestablishing corner:  
E-3 Found a Standard Kent County Monument 1.5' West of the C/L intersection of Murray Lake Avenue (bit.) running North and South and 3 Mile Road (gravel) running West per L.C.R.C.'s #1930 and #5838 as set by Rob Jonker in place of a "T" iron he found which checked L.C.R.C. #1204 and the K.C. Surveyor's records.

L.C.R.C. #1930	L.C.R.C. #5838
Remon. tag on curb joint N38°W 36.83'	Nail & remon tag in NW side 10" Elm N 40°E 55.35'
Remon. tag on NW side 6" Elm N40°E 55.35'	Nail & remon tag in N side twin 10" Ash S 77°E 42.58'
Remon. tag on N side 8" tw. Ash S77°E 42.54'	Nail & remon tag in NE side 6" Basswood S 50°E 55.32'
Remon. tag on NE side 4" Basswood S50°E 55.34'	PK nail & remon tag in top curb N 38°W 36.85'
C/L Bottom steel fe. post S46°W 47.73'	C/L bottom steel fence post S 46°W 47.69'
C/L "X" of B.T. is 1.5'E	C/L "X" of BT is 1.5'E

The selected location is accepted by me and is generally accepted by professional surveyors as the best available evidence of the position of the original corner.

C. Description of monument for corner and accessories established to perpetuate locating the position of the corner:  
E-3 Standard Kent County Monument  
Nail & K.C. remon. tag on NW side 10" Elm N 40° E 55.35'  
Nail & K.C. remon. tag on N side twin 10" Ash S 77° E 42.58'  
Nail & K.C. remon. tag on NE side 6" Basswood S 50° E 55.32'  
Nail & K.C. remon. tag on top of curb N 38° W 36.85'  
C/L bottom steel fence post S 46° W 47.69'  
C/L "X" bit. & gravel roads running N-S-W, East 1.5'

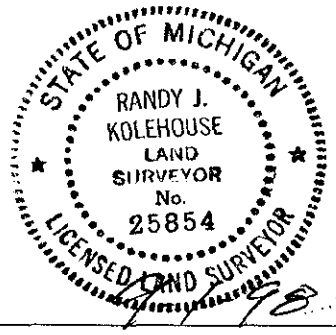

Signed by Randy J. Koblehouse Date \_\_\_\_\_  
EARTH TECH  
Surveyor's Michigan License No. 25854