

DEC 08 1999

LAND CORNER RECORDATION CERTIFICATE
Filing Requirement of Act 74, Mich. P.A. 1970
KENT COUNTY REMONUMENTATION

REG. OF DEEDS

Handwritten signature/initials

98 OCT 23 AM 9:55

STATE OF MICHIGAN
COUNTY OF KENT
RECEIVED FOR RECORD

SECTION


For corners in

Table with columns: Kent (County), Located in: Vergennes Township, Corner Code #. Rows include Public Land Survey, Property Controlling in Section, Miscellaneous Property in Sec.

10757

Register of Deeds Stamp & File Number

- 4. Lot No. , Recorded Plat
5. Private Claims

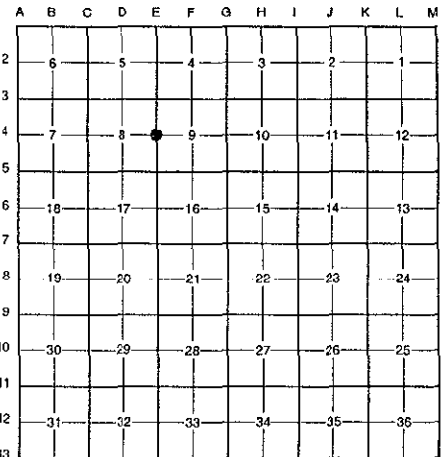

I, Randy Kolehouse, in a field survey on December 27, 1997, do hereby certify that under requirements of P.A. 74 Michigan P.A. of 1970, the corner points mentioned in lines 1 and 2 above were in conformance with regulations and rules therefore as required in the current manual of survey instructions of the United States Department of the interior, Bureau of Land Management or by a decree of a Court of Law and/or that the corner points mentioned in lines 3, 4 and 5 above were in conformance with the rules of the Michigan Board of Land Surveyors or by a Decree of a Court of Law; established, re-established, monumented, re-monumented, recovered, found as expressed below:

NOTE: Not more than 4 corners, all in the same town and range, may be recorded on this certificate.

A. Description of original monument and accessories and/or subsequent restoration:

Table with 4 columns: Description, G.L.O. Notes, Surveyor/Project Name, Monument Type. Includes entries for 1838, 1965, 1978, 1981, 1991.

P.A. 345 1990 KENT COUNTY

PEER APPROVED 2/19/98

CHAIRMAN Harry Huber

This corner was originally approved by the Kent County Remonumentation Peer Group and monumented by Rob Jonker on 7/10/81 and was recorded per L.C.R.C. #1931.

B. Description of corner evidence found and/or method applied in restoring or reestablishing corner:

E-4 Found a Standard Kent County Monument 2.5' South of the C/L intersection of Murray Lake Avenue (bit.) running North and South and Finn Road (gravel) running East and West per L.C.R.C.'s #1931 and #5839 as set by Rob Jonker in place of a solid rod he found over a stone 20" below grade which checked L.C.R.C. #1204 and the K.C. Surveyor's records.

L.C.R.C. #1931

L.C.R.C. #5839

Remon. tag on N. side p.pole S65°W 101.98'
Remon. tag on P.K. nail on curb joint N45°W 36.40'
"X" on N. end road culvert N68°E 59.56'
"X" on S. end road culvert S64°E 60.73'


PK nail & remon tag in top curb joint N 42°W 36.41'
Nail & remon tag in NW side P.Pole S 66°W 102.02'
"X" on N end road culvert N 68°E 59.61' (m. 59.71')
"X" on S end road culvert S 65°E 60.87'
C/L "X" is N 2.5'

The selected location is accepted by me and is generally accepted by professional surveyors as the best available evidence of the position of the original corner.

C. Description of monument for corner and accessories established to perpetuate location and position of the corner:

E-4 Standard Kent County Monument

Nail & K.C. remon. tag on top of curb joint N 42° W 36.41'
Nail & K.C. remon. tag on NW side P. pole S 66° W 102.02'
"X" cut N end conc. culvert N 68° E 59.71'
"X" cut S end conc. culvert S 65° E 60.87'
C/L "X" of bit. & gravel roads running N-S-E-W, North 2.5'

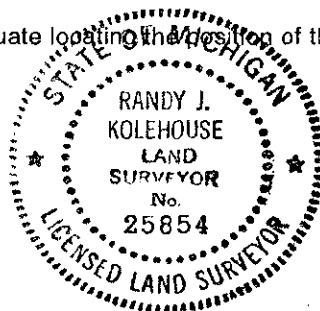

Signed by Randy J. Kolehouse

Date 9-1-98

Surveyor's Michigan License No. 25854