

CONVEY & REMONUMENTATION

\$7.00  
\$2.00

MAR 08 1999

LAND CORNER RECORDATION CERTIFICATE

Filing Requirement of Act 74, Mich. P.A. 1970

KENT COUNTY REMONUMENTATION

REG. OF DEEDS  
*David J. Land*

98 OCT 23 AM 9:56

STATE OF MICHIGAN  
COUNTY OF KENT  
RECEIVED FOR RECORD

SECTION

For corners in

Kent (County)	Located in:	Vergennes Township	Corner Code #
1. Public Land Survey	T <u>7N</u>	R <u>9W</u>	<u>E-6</u>
	T _____	R _____	_____
	T _____	R _____	_____
	T _____	R _____	_____
2. Property Controlling in Section	S _____	T _____	R _____
	S _____	T _____	R _____
3. Miscellaneous Property in Sec.	S _____	T _____	R _____
	S _____	T _____	R _____

10759

Register of Deeds Stamp & File Number


4. Lot No. \_\_\_\_\_, Recorded Plat \_\_\_\_\_  
5. Private Claims \_\_\_\_\_

I, Randy Kolehouse, in a field survey on January 23 19 98, do hereby certify that under requirements of P.A. 74 Michigan P.A. of 1970, the corner points mentioned in lines 1 and 2 above were in conformance with regulations and rules therefore as required in the current manual of survey instructions of the United States Department of the interior, Bureau of Land Management or by a decree of a Court of Law and/or that the corner points mentioned in lines 3, 4 and 5 above were in conformance with the rules of the Michigan Board of Land Surveyors or by a Decree of a Court of Law; established, re-established, monumented, re-monumented, recovered, found as expressed below:

NOTE: Not more than 4 corners, all in the same town and range, may be recorded on this certificate.

A. Description of original monument and accessories and/or subsequent restoration:

E-6	1838	G.L.O. Notes	N. Brookfield	Set Post
	N/A	Witness Map	K.C. Surveyor	N/A
	1973	L.C.R.C. #399	Williams & Works	"T" Iron
	1981	L.C.R.C. #1913	Jonker Land Survey	Fnd. "T" Iron / Set K.C. Monument
	1991	L.C.R.C. #5841	Exxel Engineering	K.C. Monument

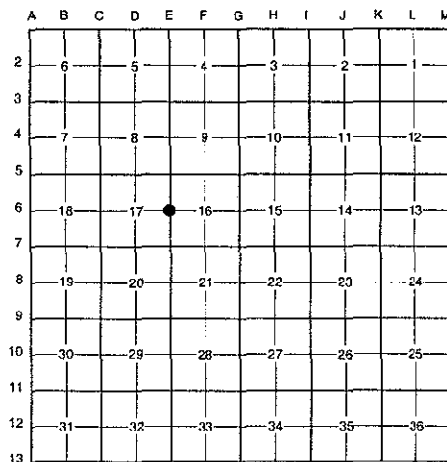

P.A. 345 1990 KENT COUNTY

PEER APPROVED 2/19/98

CHAIRMAN *[Signature]*

This corner was originally approved by the Kent County Remonumentation Peer Group and monumented by Rob Jonker on 7/14/81 and was recorded per L.C.R.C. #1913.

B. Description of corner evidence found and/or method applied in restoring or reestablishing corner:

E-6 Found a Standard Kent County Monument 6' East of intersection of fence line running North, South, East and West per L.C.R.C.'s #1913 and #5841 as set by Rob Jonker in place of a "T" iron he found which checked L.C.R.C. #399 and the K.C. Surveyor's records.

L.C.R.C. #1913

L.C.R.C. #5841

Remon. tag on N side 38" Oak N70°W 5.01'  
Remon. tag on W side 10" Maple S10°E 14.69'  
Remon. tag on W side 10" W.Cherry N01°W 28.03'  
Remon. tag on N side 6" Oak S79°E 17.74'


K.C. Mon. 0.30' below ground in roots of tree  
Nail & remon tag in N side 38" Oak N 70°W 5.01'  
Nail & remon tag in W side 10" Maple S 10°E 14.69' (m. 14.76')  
Nail & remon tag in N side 6" Oak S 79°E 17.77'  
Nail & remon tag in W side 10" Cherry N 01°E 28.05' (m. 28.11')  
Fence corner to N, E, S, W, is 6'W.

The selected location is accepted by me and is generally accepted by professional surveyors as the best available evidence of the position of the original corner.

C. Description of monument for corner and accessories established to perpetuate, locating the position of the corner:

E-6 Standard Kent County Monument

Nail & K.C. remon. tag on N side 38" Oak N 70° W 5.01'  
Nail & K.C. remon. tag on W side 10" Maple S 10° E 14.76'  
Nail & K.C. remon. tag on N side 8" Oak S 79° E 17.77'  
Nail & K.C. remon. tag on W side 10" Cherry N 01° E 28.11'  
Nail & K.C. remon. tag on W side dbl. 10" Maple N 30° E 27.84'  
Corner of fences running N-S-E-W, West 6.0'

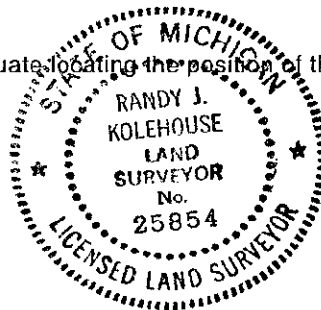

Signed by Randy J. Kolehouse

Date 9-1-98

EARTHTECH

Surveyor's Michigan License No. 25854