

\$7.00
\$2.00

MAR 08 1999

SECTION

LAND CORNER RECORDATION CERTIFICATE
Filing Requirement of Act 74, Mich. P.A. 1970
KENT COUNTY REMONUMENTATION

STATE OF MICHIGAN
COUNTY OF KENT
RECEIVED FOR RECORD
38 MAR 23 AM 9:52

REG. OF DEEDS
David J. Jones

10760

Register of Deeds Stamp & File Number

For corners in

Kent
(County)


Located in: Vergennes
Township

Corner Code #

1. Public Land Survey	T <u>7N</u>	R <u>9W</u>	<u>E-7</u>
	T _____	R _____	_____
	T _____	R _____	_____
	T _____	R _____	_____
2. Property Controlling in Section	S _____	T _____	R _____
	S _____	T _____	R _____
3. Miscellaneous Property in Sec.	S _____	T _____	R _____
	S _____	T _____	R _____

4. Lot No. _____, Recorded Plat _____
5. Private Claims _____

I, Randy Kolehouse, in a field survey on December 30 19 97, do hereby certify that under requirements of P.A. 74 Michigan P.A. of 1970, the corner points mentioned in lines 1 and 2 above were in conformance with regulations and rules therefore as required in the current manual of survey instructions of the United States Department of the Interior, Bureau of Land Management or by a decree of a Court of Law and/or that the corner points mentioned in lines 3, 4 and 5 above were in conformance with the rules of the Michigan Board of Land Surveyors or by a Decree of a Court of Law; established, re-established, monumented, re-monumented, recovered, found as expressed below:

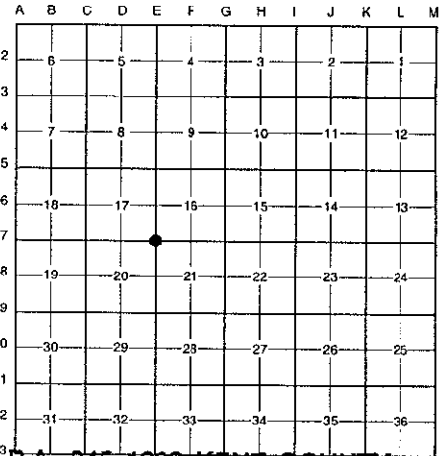

NOTE: Not more than 4 corners, all in the same town and range, may be recorded on this certificate.

A. Description of original monument and accessories and/or subsequent restoration:

E-7	1838	G.L.O. Notes	N. Brookfield	Set Post
	N/A	Witness Map	K.C. Surveyor	Stone
	1974	L.C.R.C. #737	J. Clapp	Stone / Set Steel Bar
	1981	L.C.R.C. #1764	Williams & Works	Fnd. Stone and 1/2" Iron Pipe / Set K.C. Monument
	1991	L.C.R.C. #5842	Exxcl Engineering	K.C. Monument

P.A. 345 1990 KENT COUNTY
PEER APPROVED 2/19/98
CHAIRMAN Frank Huber

This corner was originally approved by the Kent County Remonumentation Peer Group and monumented by Williams & Works on 1/15/81 and was recorded per L.C.R.C. #1764.

B. Description of corner evidence found and/or method applied in restoring or reestablishing corner:

E-7 Found a Standard Kent County Monument 2' North of the C/L of Mc Pherson Street (gravel) running East and West, on line of a tree row running North, and 4' ± East of the C/L of a two track running South per L.C.R.C.'s #1764 and #5842 as set by Williams & Works in place of a stone and 1/2" iron pipe they found which checked L.C.R.C. #737 and the K.C. Surveyor's records.

L.C.R.C. #1764

L.C.R.C. #5842

Nail & K.C. Remon. Tag in West Side 12" Ash N 05°E 26.38'
Nail & K.C. Remon. Tag in Southwest Side 10" Ash S 60°E 85.44'
Nail & K.C. Remon. Tag in East Side 10" Ash S 10°W 60.12'
Nail & K.C. Remon. Tag in Northwest Side 6" Ash S 60°W 53.24'

Nail & remon tag in W side 14" Basswood N 04°E 26.20' (m. 26.12')
Nail & remon tag in SW side 14" Ash S 61°E 85.45' (m. 85.43')
Nail & remon tag in SW side 18" Ash S 35°E 55.84' (m. 55.92')
Nail & remon tag in E side 12" Ash S 10°W 60.04' (m. 60.06')
Nail & remon tag in NW side 8" Hickory S 60°W 53.21' (m. 53.22')

The selected location is accepted by me and is generally accepted by professional surveyors as the best available evidence of the position of the original corner.

C. Description of monument for corner and accessories established to perpetuate locating the position of the corner:

E-7 Standard Kent County Monument

Nail & K.C. remon. tag on W side 14" Basswood N 04° E 26.12'
Nail & K.C. remon. tag on SW side 14" Ash S 61° E 85.43'
Nail & K.C. remon. tag on SW side 18" Ash S 35° E 55.92'
Nail & K.C. remon. tag on E side 12" Ash S 10° W 60.06'
Nail & K.C. remon. tag on N side 8" Hickory S 60° W 53.22'
Nail & K.C. remon. tag on NW face 18" Ash S 35° E 55.11'

C/L gravel road running E-W, South 2.0'
C/L of two track running S, West 4.0'
On tree row running N

Signed by Randy J. Kolehouse Date _____

EARTH TECH

Surveyor's Michigan License No. 25854

