

SUBMITTA
REMONUMENTATION

MAR 08 1999

\$7.00
\$2.00

SECTION

LAND CORNER RECORDATION CERTIFICATE
Filing Requirement of Act 74, Mich. P.A. 1970
KENT COUNTY REMONUMENTATION


For corners in

Kent (County)	Located in: Vergennes Township	Corner Code #
1. Public Land Survey	T <u>7N</u> R <u>9W</u>	<u>E-9</u>
	T _____ R _____	_____
	T _____ R _____	_____
	T _____ R _____	_____
2. Property Controlling in Section	S _____ T _____ R _____	_____
	S _____ T _____ R _____	_____
3. Miscellaneous Property in Sec.	S _____ T _____ R _____	_____
	S _____ T _____ R _____	_____
4. Lot No. _____, Recorded Plat _____		
5. Private Claims _____		

STATE OF MICHIGAN
COUNTY OF KENT
RECEIVED FOR RECORD
39 OCT 23 AM 9:57
REG. OF DEEDS
Lucy Bond

10762
Register of Deeds Stamp & File Number

I, Randy Kolehouse, in a field survey on January 6 19 98, do hereby certify that under requirements of P.A. 74 Michigan P.A. of 1970, the corner points mentioned in lines 1 and 2 above were in conformance with regulations and rules therefore as required in the current manual of survey instructions of the United States Department of the interior, Bureau of Land Management or by a decree of a Court of Law and/or that the corner points mentioned in lines 3, 4 and 5 above were in conformance with the rules of the Michigan Board of Land Surveyors or by a Decree of a Court of Law; established, re-established, monumented, re-monumented, recovered, found as expressed below:

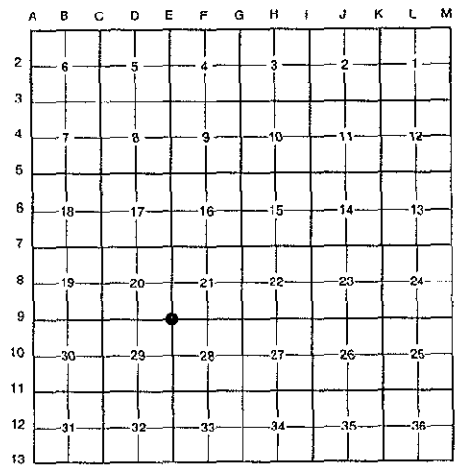

NOTE: Not more than 4 corners, all in the same town and range, may be recorded on this certificate.

A. Description of original monument and accessories and/or subsequent restoration:

E-9	1838	G.L.O. Notes	N. Brookfield	Set Post
	1971	L.C.R.C. #59	Williams & Works	"T" Iron (14.0' West)
	1974	N/A	J. Clapp	Set "T" Iron
	1984	L.C.R.C. #3997	R. Kolehouse	Reset K.C. Monument per Clapp Iron
	1991	L.C.R.C. #5844	Exxel Engineering	K.C. Monument

P.A. 345 1990 KENT COUNTY
PEER APPROVED 2/19/98
CHAIRMAN *Randy Kolehouse*

This corner was originally approved by the Kent County Remonumentation Peer Group and monumented by R. Kolehouse on 10/27/98 and was recorded per L.C.R.C. #3997.

B. Description of corner evidence found and/or method applied in restoring or reestablishing corner:

E-9 Found a Standard Kent County Monument 15.0' East of the C/L intersection of Cumberland Avenue (gravel) running South and Bailey Road (bit.) running East and West, on line of a tree row running North, per L.C.R.C.'s #3997 and #5844 as set by Randy Kolehouse in place of a capped "T" iron set by John P. Clapp in 1974.

L.C.R.C. #3997

L.C.R.C. #5844


Nail & K.C. Remon. Tag in E. side 14" Hick. S 65° W 77.75'
Nail & K.C. Remon. Tag in S. side 28" Oak N 65° W 77.75'
Nail & K.C. Remon. Tag in SE side 22" Oak N 15° E 37.67'
Nail & K.C. Remon. Tag in E. side P. pole S 30° W 93.0'

Nail & remon tag in SE side Hickory S 66° W 77.57' (m. 77.47')
Nail & remon tag in SW side 36" Oak N 65° W 77.57' (m. 77.65')
Nail & remon tag in SE side 28" Oak N 18° E 37.57' (m. 37.62')
Nail & remon tag in W side Oak S 18° E 62.66' (m. 67.66')
Nail & remon tag in E side P. pole S 28° W 92.92'

The selected location is accepted by me and is generally accepted by professional surveyors as the best available evidence of the position of the original corner.

C. Description of monument for corner and accessories established to perpetuate locating the position of the corner:

- E-9 Standard Kent County Monument
 - Nail & K.C. remon. tag on SE side 12" Hickory S 66° W 77.47'
 - Nail & K.C. remon. tag on SW side 36" Oak N 65° E 77.65'
 - Nail & K.C. remon. tag on SE side 28" Oak N 18° E 37.62'
 - Nail & K.C. remon. tag on W side 12" Oak (stump) S 18° E 62.66'
 - Nail & K.C. remon. tag on E side P. pole S 28° W 92.82'
 - On C/L of bit. road running E-W
 - C/L of gravel road running South, West 15.0'
 - On tree row running North
 - Iron per L.C.R.C. #59 was 14.0' West

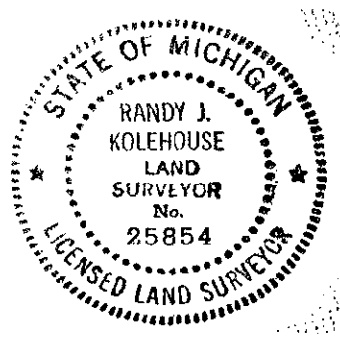

Signed by *Randy J. Kolehouse*
EARTH TECH

Date 9-1-98

-Surveyor's Michigan License No. 25854